

CORRECTION(S) TO WATER WELL RECORD (WWC-5)
(to rectify lacking or incorrect information)

County: Hamilton

Location listed as:

Section-Township-Range: 8-245-40W

Fraction (1/4 1/4 1/4): None Given

Location changed to:

8-245-40W

SW SW SW NW

Other changes: Initial statements: _____

Changed to: _____

Comments: _____

verification method: Phone call to well contractor, and mapping tool & aerial photos on KGS website.

initials: DRJ date: 10/23/2009


submitted by: Kansas Geological Survey, Data Resources Library, 1930 Constant Ave., Lawrence, KS 66047-3726
to: Kansas Dept of Health & Environment, Bureau of Water, 1000 SW Jackson, Suite 420, Topeka, KS 66612-1367.

WATER WELL RECORD Form WWC-5 KSA 82a-1212

1 LOCATION OF WATER WELL: Fraction Section Number Township Number Range Number
 COUNTY: HAMILTON 1/4 1/4 1/4 8 T 24 S R 40 W

Distance and direction from nearest town or city street address of well if located within city?
 206 N. HILL SYRACUSE, KS 67878-

2 WATER WELL OWNER: BIRT, DANNY Board of Agriculture, Division of Water Resources
 RR#, St. Address, Box #: 126 ROBIN LANE Application Number:
 City, State, ZIP code: ZUPA, TX 78076-

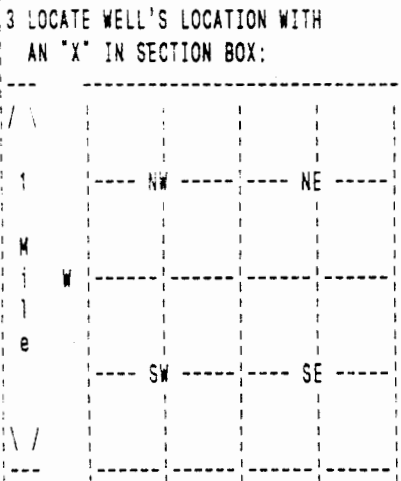

4 DEPTH OF COMPLETED WELL 224 ELEVATION: 0
 Depth(s) Groundwater Encountered 1. 0 ft. 2. 0 ft. 3. 0 ft.
 WELL'S STATIC WATER LEVEL 145 ft. below land surface measured on mo/day/yr 10/13/08
 Pump test data: Well water was 0 ft. after 0 hours pumping 0 gpm
 Estimated Yield 20 gpm: Well water was 0 ft. after 0 hours pumping 0 gpm
 Bore Hole Diameter 9 in. to 224 ft., and in. to 0 ft.
 WELL WATER TO BE USED AS: DOMESTIC
 Was a chemical/bacteriological sample submitted to department? No ;
 If yes, mo/day/yr sample was submitted Water well disinfected? Yes

5 TYPE OF BLANK CASING USED: CERTA LOC CASIN CASING JOINTS: CERTA-LOC
 Blank casing diameter 5 in. to 224 ft., Dia in. to 0 ft., Dia in. to 0 ft.
 Casing height above land surface 12 in., weight 200 lbs/ft. Wall thickness or gauge No. 21
 TYPE OF SCREEN OR PERFORATION MATERIAL: PVC
 SCREEN OR PERFORATION OPENINGS ARE: SAW CUT

SCREEN PERFORATED INTERVALS: From 160 ft. to 220 ft., From 0 ft. to 0 ft.
 From 0 ft. to 0 ft., From 0 ft. to 0 ft.
 GRAVEL PACK INTERVALS: From 25 ft. to 224 ft., From 0 ft. to 0 ft.
 From 0 ft. to 0 ft., From 0 ft. to 0 ft.

6 GROUT MATERIAL BENTONITE
 Grout Intervals: From 5 ft. to 25 ft., From 0 ft. to 0 ft., From 0 ft. to 0 ft.
 What is the nearest source of possible contamination: NONE
 Direction from well? How many feet? 0

FROM	TO	LITHOLOGIC LOG	FROM	TO	PLUGGING INTERVALS
0	20	01 TOPSOIL 05 CLAY 07 BLUE SHALE			
20	60	07 BLUE SHALE 08 ROCK LAYERS			
60	130	36 BLUE CLAY			
130	160	16 GRAY CLAY 29 SANDSTONE			
160	220	29 SANDSTONE			
220	240	29 SANDSTONE			

7 CONTRACTOR'S OR LANDOWNER'S CERTIFICATION: This water well was Constructed under my jurisdiction and was completed on (mo/day/year) 10/14/08 and this record is true to the best of my knowledge and belief. Kansas Water Well Contractor's License No. 179 This Water Well Record was completed on (mo/day/yr) 10/23/08 under the business name of JOE'S WELL SERVICE, INC. by (signature) *Judith Creek*