


WATER WELL PLUGGING RECORD Form WWC-5P KSA 82a-1212 ID NO.

1 LOCATION OF WATER WELL: Fraction SW 1/4 NE 1/4 NE 1/4 SE 1/4 Section Number 7 Township Number T 24 S Range Number 40

Street/Rural Address of Well Location; if unknown, distance & direction from nearest town or intersection: If at owner's address, check here 707 E. Avenue A Syracuse, KS 67878 Global Positioning Systems (GPS) information: Latitude: 37.97789 Longitude: -101.74442

2 WATER WELL OWNER: Skyland Grain, LLC RR#, St. Address, Box #: 304 E. Highland Ave. City, State ZIP Code: Johnson City, KS 67855

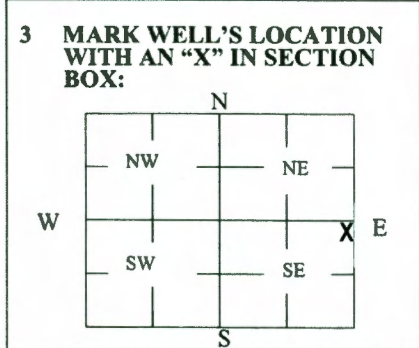

4 DEPTH OF WELL 21.1 ft. WELL'S STATIC WATER LEVEL 13.0 ft. WELL WAS USED AS: Domestic, Irrigation, Feedlot, Industrial, Public Water Supply, Oil Field Water Supply, Domestic (Lawn & Garden), Air Conditioning, Dewatering, Monitoring, Injection Well, Other

5 TYPE OF BLANK CASING USED: Steel, PVC, RMP (SR), ABS, Wrought, Asbestos-Cement, Fiberglass, Concrete Tile, Other. Blank casing diameter 1 in. Was casing pulled? Yes No

6 GROUT PLUG MATERIAL: Neat cement, Cement grout, Bentonite, Other. Grout Plug Intervals: From 0 ft. to 13.0 ft., From ft. to ft., From ft. to ft. What is the nearest source of possible contamination: Septic tank, Sewer lines, Watertight sewer lines, Lateral lines, Cess pool, Seepage pit, Pit privy, Sewage lagoon, Feedyard, Livestock pens, Fuel storage, Fertilizer storage, Insecticide storage, Abandoned water well, Oil well/Gas well

Table with columns: FROM, TO, PLUGGING MATERIALS. Rows: 0 to 13.0 (Bentonite chips), 13.0 to 21.1 (Native sand (wet cave-in))

7 CONTRACTOR'S OR LANDOWNER'S CERTIFICATION: This water well was plugged under my jurisdiction and was completed on (mo/day/year) 8/12/21 and this record is true to the best of my knowledge and belief. Kansas Water Well Contractor's License No. 416. This Water Well Record was completed on (mo/day/year) 9/16/21 under the business name of Terracon Consultants, Inc. by (signature) Michael W. Montgomerie

Send one white copy to Kansas Department of Health & Environment, Geology Section, 1000 SW Jackson Street, Ste. 420, Topeka, KS 66612-1367. Send one copy to WATER WELL OWNER and retain one for your records. Visit us at http://www.kdheks.gov/waterwell/index.html Telephone 785-296-5524.