


1	LOCATION OF WATER WELL:	Fraction	Section Number	Township Number	Range Number
	County: <u>HAMILTON</u>	<u>NW</u> $\frac{1}{4}$ <u>SE</u> $\frac{1}{4}$ <u>NW</u> $\frac{1}{4}$	<u>7</u>	T <u>24</u> S	R <u>40</u> E <u>2</u>

Distance and direction from nearest town or city street address of well if located within city?  
22' S of N property line of David Jantz property and 24' W of W edge of alley MW-7

2 WATER WELL OWNER: Gary Rash - Rash oil #4  
RR#, St. Address, Box # : Hwy 50 & Durfee  
City, State, ZIP Code : Syracuse, KS 67878

3 LOCATE WELL'S LOCATION WITH AN "X" IN SECTION BOX: 4 DEPTH OF COMPLETED WELL... 25... ft. ELEVATION: ...  
Depth(s) Groundwater Encountered: 1' 1' 2' 3' 8

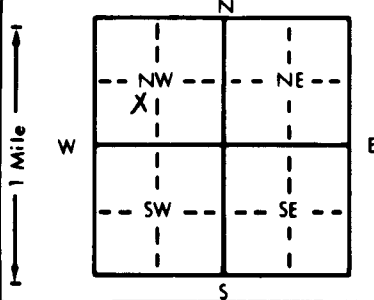

4) DEPTH OF COMPLETED WELL. 25 ft. ELEVATION: \_\_\_\_\_

Depth(s) Groundwater Encountered 1 ft. 18 ft. 2. \_\_\_\_\_ ft. 3. \_\_\_\_\_ ft.

WELL'S STATIC WATER LEVEL 18.46 ft. below land surface measured on mo/day/yr 3/27/95

Pump test data: Well water was \_\_\_\_\_ ft. after \_\_\_\_\_ hours pumping \_\_\_\_\_ gpm

Est. Yield \_\_\_\_\_ gpm: Well water was \_\_\_\_\_ ft. after \_\_\_\_\_ hours pumping \_\_\_\_\_ gpm

Bore Hole Diameter 8 in. to 25 ft., and \_\_\_\_\_ in. to \_\_\_\_\_ ft.

WELL WATER TO BE USED AS:

5 Public water supply	8 Air conditioning	11 Injection well		
1 Domestic	3 Feedlot	6 Oil field water supply	9 Dewatering	12 Other (Specify below)
2 Irrigation	4 Industrial	7 Lawn and garden only	10 Monitoring well	

Was a chemical/bacteriological sample submitted to Department? Yes \_\_\_\_\_ (No) \_\_\_\_\_; If yes, mo/day/yr sample was submitted \_\_\_\_\_

Water Well Disinfected? Yes \_\_\_\_\_ (No) \_\_\_\_\_

5 TYPE OF BLANK CASING USED:		5 Wrought iron	8 Concrete tile	CASING JOINTS: Glued . . . . . Clamped . . . . .	
1 Steel	3 RMP (SR)	6 Asbestos-Cement	9 Other (specify below)	Welded . . . . .	
② PVC	4 ABS	7 Fiberglass		③ Threaded . . . . .	

Blank casing diameter . . . . . 2 . . . . . in. to 15 . . . . . ft., Dia . . . . . in. to . . . . . ft., Dia . . . . . in. to . . . . . ft.

Casing height above land surface . . . . . 0 . . . . . in. weight . . . . . lbs./ft. Wall thickness or gauge No . . . . .

TYPE OF SCREEN OR PERFORATION MATERIAL:				
1 Steel	3 Stainless steel	5 Fiberglass	7 PVC	10 Asbestos-cement
2 Brass	4 Galvanized steel	6 Concrete tile	8 RMP (SR)	11 Other (specify) . . . . .
			9 ABS	12 None used (open hole)

SCREEN OR PERFORATION OPENINGS ARE:

1 Continuous slot	3 Mill slot	5 Gauzed wrapped	8 Saw cut	11 None (open hole)
2 Louvered shutter	4 Key punched	6 Wire wrapped	9 Drilled holes	
		7 Torch cut	10 Other (specify) .....	

SCREEN-PERFORATED INTERVALS: From 25 ft. to 25 ft., From . . . . . ft. to . . . . . ft.  
From . . . . . ft. to . . . . . ft., From . . . . . ft. to . . . . . ft.  
GRAVEL PACK INTERVALS: From 14 ft. to 25 ft., From . . . . . ft. to . . . . . ft.  
From . . . . . ft. to . . . . . ft., From . . . . . ft. to . . . . . ft.

6 GROUT MATERIAL: 1 Neat cement 2 Cement grout 3 Bentonite 4 Other  
Grout Intervals: From 0 ft. to 12.0 ft., From 12.0 ft. to 14.0 ft., From . ft. to . ft.

What is the nearest source of possible contamination:

1 Septic tank	4 Lateral lines	7 Pit privy	10 Livestock pens	14 Abandoned water well
2 Sewer lines	5 Cess pool	8 Sewage lagoon	11 Fuel storage	15 Oil well/Gas well
3 Watertight sewer lines	6 Seepage pit	9 Feedyard	12 Fertilizer storage	16 Other (specify below)
			13 Insecticide storage	

Direction from well? NE How many feet? 125'

[illegible]

7 CONTRACTOR'S OR LANDOWNER'S CERTIFICATION: This water well was (1) constructed, (2) reconstructed, or (3) plugged under my jurisdiction and was completed on (mo/day/year) 3/26/95 and this record is true to the best of my knowledge and belief. Kansas Water Well Contractor's License No. 438 This Water Well Record was completed on (mo/day/yr) 4/10/95 under the business name of Kansas City Testing Labs by (signature) [Signature]