


WATER WELL RECORD Form NWC-5 KSA 82a-1212

1 LOCATION OF WATER WELL: Fraction Section Number Township Number Range Number  
 COUNTY: HAMILTON NE 1/4 SE 1/4 NE 1/4 11 T 24 S R 41 W

Distance and direction from nearest town or city street address of well if located within city?  
 FROM SYRACUSE 1 MILE WEST ON HIGHWAY 50 1/4 MILE SOUTH

2 WATER WELL OWNER: BOGAN, KEVIN  
 RRP, St. Address, Box #: BOX 449 Board of Agriculture, Division of Water Resources  
 City, State, ZIP code: SYRACUSE, KS 67878- Application Number:

3 LOCATE WELL'S LOCATION WITH AN "X" IN SECTION BOX:

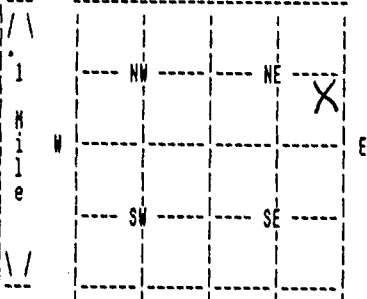

4 DEPTH OF COMPLETED WELL 385 ELEVATION: 0  
 Depth(s) Groundwater Encountered 1. 0 ft. 2. 0 ft. 3. 0 ft.

WELL'S STATIC WATER LEVEL 161 ft. below land surface measured on no/day/yr 04/29/97  
 Pump test data: Well water was 0 ft. after 0 hours pumping 0 gpm

Estimated Yield 20 gpm: Well water was 0 ft. after 0 hours pumping 0 gpm

Bore Hole Diameter 10 in. to 385 ft., and in. to 0 ft.

WELL WATER TO BE USED AS: DOMESTIC

Was a chemical/bacteriological sample submitted to department? No ;  
 If yes, no/day/yr sample was submitted Water well disinfected? Yes

5 TYPE OF BLANK CASING USED: PVC CASING JOINTS: GLUED  
 Blank casing diameter 5 in. to 385 ft., Dia in. to 0 ft., Dia in. to 0 ft.  
 Casing height above land surface 12 in., weight 200 lbs/ft. Wall thickness or gauge No. 21  
 TYPE OF SCREEN OR PERFORATION MATERIAL: PVC  
 SCREEN OR PERFORATION OPENINGS ARE: SAW CUT

SCREEN PERFORATED INTERVALS: From 280 ft. to 320 ft., From 0 ft. to 0 ft.  
 From 360 ft. to 380 ft., From 0 ft. to 0 ft.  
 GRAVEL PACK INTERVALS: From 120 ft. to 385 ft., From 0 ft. to 0 ft.  
 From 0 ft. to 0 ft., From 0 ft. to 0 ft.

6 GROUT MATERIAL BENTONITE  
 Grout Intervals: From 0 ft. to 120 ft., From 0 ft. to 0 ft., From 0 ft. to 0 ft.  
 What is the nearest source of possible contamination: ABANDONED WELL  
 Direction from well? EAST How many feet? 75

FROM	TO	LITHOLOGIC LOG	FROM	TO	PLUGGING INTERVALS
0	20	TOPSOIL CLAY FINE - MED SAND			
20	57	MED-COARSE SAND LARGE GRAVEL			
57	140	BLUE SHALE			
140	160	BLUE SHALE ROCK LAYERS			
160	180	ROCK LAYERS GRAY CLAY SANDSTONE			
180	200	GRAY CLAY SANDSTONE			
200	335	SANDSTONE			
335	355	BLUE SHALE ROCK LAYERS			
355	400	SANDSTONE			

7 CONTRACTOR'S OR LANDOWNER'S CERTIFICATION: This water well was constructed under my jurisdiction and was completed on (no/day/year) 04/30/97 and this record is true to the best of my knowledge and belief. Kansas Water Well Contractor's License No. 179 This Water Well Record was completed on (no/day/yr) 05/01/97 under the business name of JOE'S WELL SERVICE, INC. by (signature) *Joel Crick*