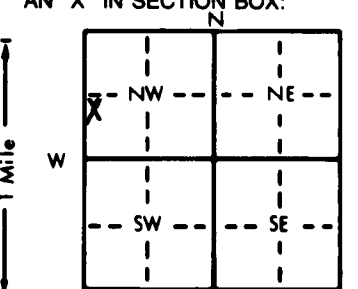


1 LOCATION OF WATER WELL: Fraction NW 1/4 SW 1/4 NW 1/4 Section Number 31 Township Number T 24 S Range Number R 41 E 10  
 County: Hamilton

Distance and direction from nearest town or city street address of well if located within city?  
 1/2 mile south 7m west Syracuse Ks

2 WATER WELL OWNER: Harry Reed  
 RR#, St. Address, Box # : Box 133 Board of Agriculture, Division of Water Resources  
 City, State, ZIP Code : Coolidge, Ks 67836 Application Number:

3 LOCATE WELL'S LOCATION WITH AN "X" IN SECTION BOX:  


4 DEPTH OF COMPLETED WELL: 380 ft. ELEVATION:  
 Depth(s) Groundwater Encountered 1. . . . . ft. 2. . . . . ft. 3. . . . . ft.  
 WELL'S STATIC WATER LEVEL: 160 ft. below land surface measured on mo/day/yr 6-1-86  
 Pump test data: Well water was . . . . . ft. after . . . . . hours pumping . . . . . gpm  
 Est. Yield: 30 gpm; Well water was . . . . . ft. after . . . . . hours pumping . . . . . gpm  
 Bore Hole Diameter: 7.8 in. to . . . . . ft., and . . . . . in. to . . . . . ft.  
 WELL WATER TO BE USED AS:  
 Domestic 3 Feedlot 6 Oil field water supply 9 Dewatering 12 Other (Specify below)  
 2 Irrigation 4 Industrial 7 Lawn and garden only 10 Observation well  
 Was a chemical/bacteriological sample submitted to Department? Yes . . . . . No ; If yes, mo/day/yr sample was submitted  
 Water Well Disinfected? Yes  No

5 TYPE OF BLANK CASING USED:  
 1 Steel 3 RMP (SR) 5 Wrought iron 8 Concrete tile CASING JOINTS: Glued . . . . . Clamped . . . . .  
 PVC 4 ABS 6 Asbestos-Cement 9 Other (specify below) Welded . . . . .  
 7 Fiberglass . . . . . Threaded . . . . .  
 Blank casing diameter . . . . . in. to . . . . . ft., Dia . . . . . in. to . . . . . ft., Dia . . . . . in. to . . . . . ft.  
 Casing height above land surface: 18 in., weight . . . . . lbs./ft. Wall thickness or gauge No. . . . .  
 TYPE OF SCREEN OR PERFORATION MATERIAL:  
 1 Steel 3 Stainless steel 5 Fiberglass 8 RMP (SR) 10 Asbestos-cement  
 2 Brass 4 Galvanized steel 6 Concrete tile 9 ABS 11 Other (specify) . . . . .  
 12 None used (open hole)  
 SCREEN OR PERFORATION OPENINGS ARE:  
 1 Continuous slot 3 Mill slot 5 Gauzed wrapped 8 Saw cut 11 None (open hole)  
 2 Louvered shutter 4 Key punched 6 Wire wrapped 9 Drilled holes  
 7 Torch cut 10 Other (specify) . . . . .  
 SCREEN-PERFORATED INTERVALS: From . . . 200 . . . . . ft. to . . . 380 . . . . . ft., From . . . . . ft. to . . . . . ft.  
 From . . . . . ft. to . . . . . ft., From . . . . . ft. to . . . . . ft.  
 GRAVEL PACK INTERVALS: From . . . . . ft. to . . . . . ft., From . . . . . ft. to . . . . . ft.  
 From . . . . . ft. to . . . . . ft., From . . . . . ft. to . . . . . ft.

6 GROUT MATERIAL:  Neat cement 2 Cement grout 3 Bentonite 4 Other . . . . .  
 Grout Intervals: From . . . 0 . . . . . ft. to . . . 15 . . . . . ft., From . . . . . ft. to . . . . . ft., From . . . . . ft. to . . . . . ft.  
 What is the nearest source of possible contamination:  
 1 Septic tank 4 Lateral lines 7 Pit privy 10 Livestock pens 14 Abandoned water well  
 2 Sewer lines 5 Cess pool 8 Sewage lagoon 11 Fuel storage 15 Oil well/Gas well  
 3 Watertight sewer lines 6 Seepage pit 9 Feedyard 12 Fertilizer storage 16 Other (specify below)  
 13 Insecticide storage . . . . .  
 Direction from well? How many feet?

FROM	TO	LITHOLOGIC LOG	FROM	TO	LITHOLOGIC LOG
0	42	Fine Sand - Tan			
42	67	Fine Gravel			
67	74	Clay + Gravel			
74	148	Shale w Sandstone Layers			
148	152	Sandstone Hard - Fine, Silty			
152	185	Shale			
185	318	Sandstone v fine, silty			
318	332	Sandstone - Med. Soft!			
332	380	Sandstone - Hard			

7 CONTRACTOR'S OR LANDOWNER'S CERTIFICATION: This water well was  constructed, (2) reconstructed, or (3) plugged under my jurisdiction and was completed on (mo/day/year) . . . 6-1-86 . . . . . and this record is true to the best of my knowledge and belief. Kansas  
 Water Well Contractor's License No. 365 . . . . . This Water Well Record was completed on (mo/day/yr) 7-10-86 . . . . .  
 under the business name of Norman Hill Drilling Co. by (signature)

INSTRUCTIONS: Use typewriter or ball point pen. PLEASE PRESS FIRMLY and PRINT clearly. Please fill in blanks, underline or circle the correct answers. Send top three copies to Kansas Department of Health and Environment, Bureau of Water Protection, Topeka, Kansas 66620-7320, Telephone: 913-862-9360. Send one to WATER WELL OWNER and retain one for your records.

RECEIVED

JUL 21 1986


USE TYPEWRITER OR BALL POINT PEN-PRESS FIRMLY, PRINT CLEARLY.

WATER WELL RECORD KSA 82a-1201-1215

Kansas Department of Health and Environment-Division of Environment (Water well Contractors) Topeka, Kansas 66620

DIVISION OF ENVIRONMENT

1. Location of well: County Hamilton, Fraction NW 1/4 SW 1/4 NW 1/4, Section number 31, Township number T 24 S R 41 E/W. 2. Distance and direction from nearest town or city: West Syracuse, Ks. 3. Owner of well: Harry Reed, R.R. or street: Box 133, City, state, zip code: Coolidge, Ks 67836

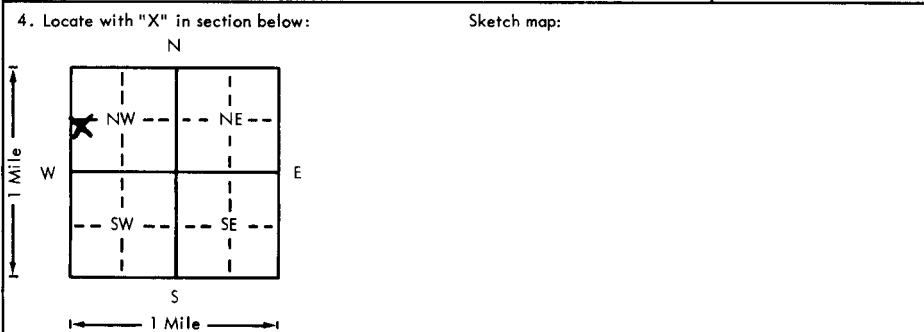

6. Bore hole dia. 7.8 in. Completion date 6-1-86. Well depth 380 ft. 7. Cable tool X Rotary. 8. Use: Stock. 9. Casing: Material PVC, Height: 18 in. Dia. 6 in. to 280 ft. depth. Wall Thickness: SDR-17.

Table with 3 columns: Material description, From, To. Rows include: Fine Sand - Tan (0-42), Fine Gravel (42-67), Clay & Gravel - Brown (67-74), Shale - Blue with Sandstone Layers (74-148), Sandstone Hard - Fine - Silty (148-152), Shale - Blue with Sandstone Layers (152-185), Sandstone v Fine, Silty - Grey with shale layers (185-318), Sandstone Med Soft - Tan (318-332), Sandstone - Hard with soft layers (332-380).

10. Screen: Manufacturer's name Peerless, Type PVC, Dia. 6 in, Slot/gauze .032, Length 180. 11. Static water level: 160 ft. below land surface. 12. Pumping level below land surfaces: Estimated maximum yield 30 g.p.m. 13. Water sample submitted: Yes X No. 14. Well head completion: Pitless adapter. 15. Well grouted? Yes. 16. Nearest source of possible contamination: Well disinfected upon completion? X Yes. 17. Pump: Manufacturer's name GouTs, Model number 10251540, Volts 230, Length of drop pipe 280 ft. capacity 10 g.p.m. Type: Submersible.

18. Elevation: Topography: Upland (checked). 19. Remarks: (Use a second sheet if needed)

20. Water well contractor's certification: This well was drilled under my jurisdiction and this report is true to the best of my knowledge and belief. Norman Hill Drilling Co 365, License No. 10251540, Address: P.O. Box 783 Lamar, CO 81052, Signed: Norman L. Hill, Date: 7-10-86.