


1 LOCATION OF WATER WELL: Fraction Near Center Section Number _____ Township Number _____ Range Number _____
 County: Hamilton $\frac{1}{4}$ $\frac{1}{2}$ $\frac{3}{4}$ W 1/2 SW 1/4 2 24 S 41 EW

Distance and direction from nearest town or city street address of well if located within city?
Approx. 2 mi. West and 200yds south of Hwy 50 from Syracuse west city limit.

2 WATER WELL OWNER: Richard E. Cheatum
 RR #, St. Address, Box #: Heol Box 79 Board of Agriculture, Division of Water Resources
 City, State, ZIP Code: Syracuse, KS 67878 Application Number: 8719

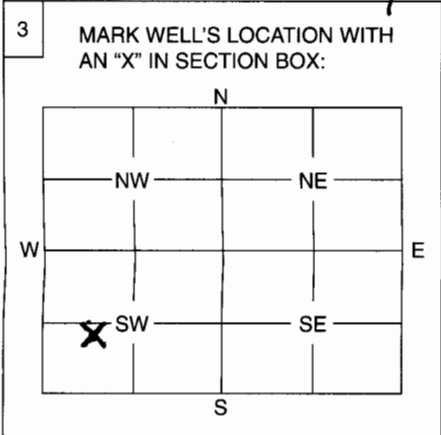

4 DEPTH OF WELL 54 ft.
 WELL'S STATIC WATER LEVEL ~~14~~ ft.
 WELL WAS USED AS:
 1 Domestic 5 Public Water Supply 9 Dewatering
 2 Irrigation 6 Oil Field Water Supply 10 Monitoring Well
 3 Feedlot 7 Domestic (Lawn & Garden) 11 Injection Well
 4 Industrial 8 Air Conditioning 12 Other
 Was a chemical / bacteriological sample submitted to Department? Yes No
 If yes, mo/day/yr sample was submitted
 Water Well Disinfected: Yes No

5 TYPE OF BLANK CASING USED:
 1 Steel 3 RMP (SR) 5 Wrought 7 Fiberglass 9 Other (Specify below)
 2 PVC 4 ABS 6 Asbestos-Cement 8 Concrete Tile
 Blank casing diameter 16 in. Was casing pulled? Yes No If yes, how much
 Casing height above or below land surface 5 ft. in. 60 ft.

6 GROUT PLUG MATERIAL: 1 Neat cement 2 Cement grout 3 Bentonite 4 Other
 Grout Plug Intervals: From 54 ft. to 14 ft., From 14 ft. to 12 ft., From 12 to 9 ft.
 What is the nearest source of possible contamination:
 1 Septic tank 6 Seepage pit 11 Fuel storage 16 Other (specify below) Sand pit
 2 Sewer lines 7 Pit privy 12 Fertilizer storage
 3 Watertight sewer lines 8 Sewage lagoon 13 Insecticide storage
 4 Lateral lines 9 Feedyard 14 Abandoned water well
 5 Cess pool 10 Livestock pens 15 Oil well/Gas well
 Direction from well? West How many feet? 50'

FROM	TO	PLUGGING MATERIALS
<u>54</u>	<u>14</u>	<u>washed sand.</u>
<u>14</u>	<u>12</u>	<u>sand + dirt fill</u>
<u>12</u>	<u>9</u>	<u>Bentonite</u>
<u>casing was cut off 9 ft. from top to make sure it was out of any possible way for farming over the site.</u>		

7 CONTRACTOR'S OF LANDOWNER'S CERTIFICATION: This water well was plugged under my jurisdiction and was completed on (mo/day/year) 5/18/2007 and this record is true to the best of my knowledge and belief. Kansas Water Well Contractor's License No. N/A This Water Well Record was completed on (mo/day/year) 5/23/2007 under the business name of Jamie K. Cheatum (Tenant) by (signature) Jamie K. Cheatum

INSTRUCTIONS: Use typewriter or ball point pen. Please press firmly and print clearly. Please fill in blanks, underline or circle the correct answers. Send top three copies to Kansas Department of Health and Environment, Bureau of Water, Geology Section, 1000 SW Jackson St., Ste. 420, Topeka, Kansas 66612-1367. Telephone: 785/296-5522. Send one to Water Well Owner and retain one for your records.