


WATER WELL RECORD Form WWC-5 KSA 82a-1212

1 LOCATION OF WATER WELL: Fraction Section Number Township Number Range Number
 COUNTY: HAMILTON NW 1/4 SE 1/4 NE 1/4 36 T 24 S R 41 W

Distance and direction from nearest town or city street address of well if located within city?
 FROM SYRACUSE ON HIGHWAY 27 - 3 MILES SOUTH

2 WATER WELL OWNER: FULLMER CATTLE COMPANY *Well # 2*
 RR#, St. Address, Box #: PO BOX 986 Board of Agriculture, Division of Water Resources
 City, State, ZIP code: SYRACUSE, KS 67878- Application Number:

3 LOCATE WELL'S LOCATION WITH AN "X" IN SECTION BOX:

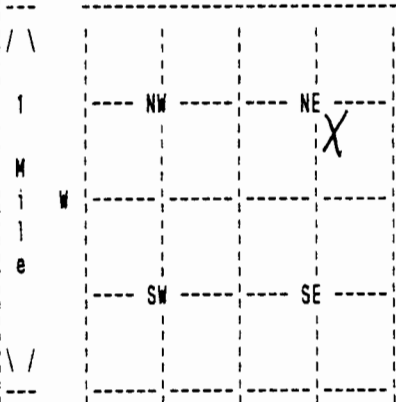

4 DEPTH OF COMPLETED WELL 365 ELEVATION: 0
 Depth(s) Groundwater Encountered 1. 0 ft. 2. 0 ft. 3. 0 ft.

WELL'S STATIC WATER LEVEL 134 ft. below land surface measured on mo/day/yr 07/15/07
 Pump test data: Well water was 0 ft. after 0 hours pumping 0 gpm
 Estimated Yield 40 gpm: Well water was 0 ft. after 0 hours pumping 0 gpm
 Bore Hole Diameter 10 in. to 365 ft., and in. to 0 ft.
 WELL WATER TO BE USED AS: DOMESTIC

Was a chemical/bacteriological sample submitted to department? No ;
 If yes, mo/day/yr sample was submitted Water well disinfected? Yes

5 TYPE OF BLANK CASING USED: CERTA LOC CASIN CASING JOINTS: CERTA-LOC
 Blank casing diameter 5 in. to 365 ft., Dia in. to 0 ft., Dia in. to 0 ft.
 Casing height above land surface 12 in., weight 200 lbs/ft. Wall thickness or gauge No. 21 17
 TYPE OF SCREEN OR PERFORATION MATERIAL: PVC
 SCREEN OR PERFORATION OPENINGS ARE: SAW CUT

SCREEN PERFORATED INTERVALS: From 280 ft. to 360 ft., From 0 ft. to 0 ft.
 From 0 ft. to 0 ft., From 0 ft. to 0 ft.
 GRAVEL PACK INTERVALS: From 26 ft. to 110 ft., From 0 ft. to 0 ft.
 From 120 ft. to 365 ft., From 0 ft. to 0 ft.

6 GROUT MATERIAL BENTONITE
 Grout Intervals: From 6 ft. to 26 ft., From 110 ft. to 120 ft., From 0 ft. to 0 ft.
 What is the nearest source of possible contamination: NONE
 Direction from well? How many feet? 0

FROM	TO	LITHOLOGIC LOG	FROM	TO	PLUGGING INTERVALS
0	20	01 TOPSOIL 05 CLAY 02 FINE SAND			
20	40	02 FINE SAND 32 TAN CLAY 02 FINE SAND			
40	60	02 FINE SAND 32 TAN CLAY 19 LAYERS			
60	70	37 FIN-COAR SAN 38 SHAL-MED GRA			
70	140	07 BLUE SHALE			
140	180	07 BLUE SHALE 29 SANDSTONE 19 LAYERS			
180	200	29 SANDSTONE 08 ROCK LAYERS			
200	240	29 SANDSTONE 27 ROCK 16 GRAY CLAY			
240	370	29 SANDSTONE			

7 CONTRACTOR'S OR LANDOWNER'S CERTIFICATION: This water well was Constructed under my jurisdiction and was completed on (mo/day/year) 07/16/07 and this record is true to the best of my knowledge and belief. Kansas Water Well Contractor's License No. 179 This Water Well Record was completed on (mo/day/yr) 08/07/07 under the business name of JOE'S WELL SERVICE, INC. by (signature) *Jessie Cuet*