


1 LOCATION OF WATER WELL: County: Hamilton	Fraction SE 1/4 SE 1/4 SW 1/4	Section Number 25	Township Number T 24 S	Range Number R 41 E/W
--	---	-----------------------------	----------------------------------	---------------------------------

Distance and direction from nearest town or city street address of well if located within city?
From Syracuse - 3 Miles South on Hwy. 27, 1/2 Mile West, 62 Ft. North & 110 Ft. West

2 WATER WELL OWNER: **Marvin Graber**
 RR#, St. Address, Box # : **700 Edward**
 City, State, ZIP Code : **Lakin, Kansas 67860**
 Board of Agriculture, Division of Water Resources
 Application Number:

3 LOCATE WELL'S LOCATION WITH AN "X" IN SECTION BOX:

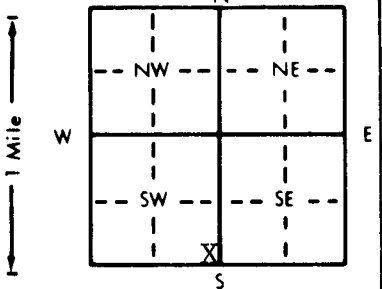

4 DEPTH OF COMPLETED WELL: **230** ft. ELEVATION: ft.
 Depth(s) Groundwater Encountered 1. ft. 2. ft. 3. ft.
 WELL'S STATIC WATER LEVEL: **100** ft. below land surface measured on mo/day/yr **9-9-94**
 Pump test data: Well water was ft. after hours pumping gpm
 Est. Yield gpm: Well water was ft. after hours pumping gpm
 Bore Hole Diameter: **10-5/8** in. to **230** ft., and in. to ft.
 WELL WATER TO BE USED AS:
 1 Domestic 3 Feedlot 6 Oil field water supply 9 Dewatering 12 Other (Specify below)
 2 Irrigation 4 Industrial 7 Lawn and garden only 10 Monitoring well
 Was a chemical/bacteriological sample submitted to Department? Yes.....No ; If yes, mo/day/yr sample was submitted
 Water Well Disinfected? Yes No

5 TYPE OF BLANK CASING USED:
 1 Steel 3 RMP (SR) 5 Wrought iron 8 Concrete tile CASING JOINTS: Glued Clamped
 2 PVC 4 ABS 6 Asbestos-Cement 9 Other (specify below) Welded
 Blank casing diameter **5** in. to **170** ft., Dia in. to ft., Dia in. to ft.
 Casing height above land surface **12** in., weight **2.81** lbs./ft. Wall thickness or gauge No. **265**
 TYPE OF SCREEN OR PERFORATION MATERIAL:
 1 Steel 3 Stainless steel 5 Fiberglass 7 PVC 10 Asbestos-cement
 2 Brass 4 Galvanized steel 6 Concrete tile 8 RMP (SR) 11 Other (specify)
 3 None used (open hole)
 SCREEN OR PERFORATION OPENINGS ARE:
 1 Continuous slot 3 Mill slot 5 Gauzed wrapped 8 Saw cut 11 None (open hole)
 2 Louvered shutter 4 Key punched 6 Wire wrapped 9 Drilled holes
 7 Torch cut 10 Other (specify)

SCREEN-PERFORATED INTERVALS: From **170** ft. to **230** ft., From ft. to ft.
 From ft. to ft., From ft. to ft.
 GRAVEL PACK INTERVALS: From **130** ft. to **230** ft., From ft. to ft.
 From ft. to ft., From ft. to ft.

6 GROUT MATERIAL: 1 Neat cement 2 Cement grout 3 Bentonite 4 Other
 Grout Intervals: From **5** ft. to **25** ft., From **25** ft. to **130** ft., From ft. to ft.
 What is the nearest source of possible contamination:
 1 Septic tank 4 Lateral lines 7 Pit privy 10 Livestock pens 14 Abandoned water well
 2 Sewer lines 5 Cess pool 8 Sewage lagoon 11 Fuel storage 15 Oil well/Gas well
 3 Watertight sewer lines 6 Seepage pit 9 Feedyard 12 Fertilizer storage 16 Other (specify below)
 13 Insecticide storage
 Direction from well? How many feet?

FROM	TO	LITHOLOGIC LOG	FROM	TO	PLUGGING INTERVALS
		See attached log			

7 CONTRACTOR'S OR LANDOWNER'S CERTIFICATION: This water well was (1) constructed, (2) reconstructed, or (3) plugged under my jurisdiction and was completed on (mo/day/year) **9-15-94** and this record is true to the best of my knowledge and belief. Kansas Water Well Contractor's License No. **208** This Water Well Record was completed on (mo/day/yr) **9-21-94** under the business name of **Minter-Wilson Drilling Co., Inc.** by (signature) *Nora Keller*

*The
Professionals*

MINTER-WILSON DRILLING CO.

INCORPORATED

Irrigation
and Domestic
Water Systems
Complete Installation
and Repairing

Phone 276-8269 • P.O. Box A • GARDEN CITY, KANSAS 67846

Marvin Graber
Hamilton County
9-9-94

Location: SE $\frac{1}{4}$ SE $\frac{1}{4}$ SW $\frac{1}{4}$ 25-24-41
From Syracuse - 3 Miles South, $\frac{1}{2}$ Mile
West, 62 Ft. North & 110 Ft. West

Static Water Level - 100'

Test #1

0' to 1' - Top soil
1' to 9' - Fine sand - loose
9' to 39' - Fine to medium sand and gravel
39' to 42' - Yellow clay
42' to 137' - Shale - hard pull down
137' to 218' - Dakota - 50% sand stone - hard pull down
218' to 223' - Shale - hard pull down
223' to 231' - Dakota - 25% sand stone - hard pull down
231' to 260' - Dakota shale - hard pull down