


1 LOCATION OF WATER WELL: COUNTY: HAMILTON Fraction NE 1/4 SW 1/4 NE 1/4 Section Number 5 Township Number T 24 S Range Number R 42 W

Distance and direction from nearest town or city street address of well if located within city?
FROM SYRACUSE, KS. - 1 M S, 11 M W., 3/4 M S AND 3/4 M. EAST

2 WATER WELL OWNER: TRIPLE T FARMS RR#, St. Address, Box #: BOX 69 City, State, ZIP code : LAKIN, KS 67860- Board of Agriculture, Division of Water Resources Application Number:

3 LOCATE WELL'S LOCATION WITH AN "X" IN SECTION BOX:

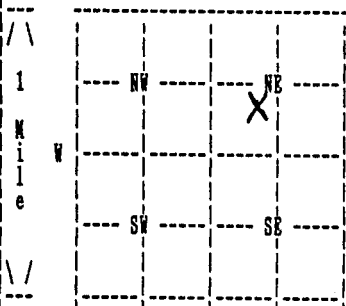

4 DEPTH OF COMPLETED WELL 260 ELEVATION: 0
Depth(s) Groundwater Encountered 1. 0 ft. 2. 0 ft. 3. 0 ft.

WELL'S STATIC WATER LEVEL 41 ft. below land surface measured on no/day/yr 05/12/93
Pump testdata: Well water was 0 ft. after 0 hours pumping 0 gpm

Estimated Yield 60 gpm: Well water was 0 ft. after 0 hours pumping 0 gpm

Bore Hole Diameter 9 in. to 260 ft., and in. to 0 ft.

WELL WATER TO BE USED AS: DOMESTIC

Was a chemical/bacteriological sample submitted to department? No ;
If yes, no/day/yr sample was submitted Water well disinfected? Yes

5 TYPE OF BLANK CASING USED: PVC CASING JOINTS: GLOED
Blank casing diameter 5 in. to 260 ft., Dia in. to 0 ft., Dia in. to 0 ft.
Casing height above land surface 12 in., weight 200 lbs/ft. Wall thickness or gauge No. 21
TYPE OF SCREEN OR PERFORATION MATERIAL: PVC
SCREEN OR PERFORATION OPENINGS ARE: SAW CUT

SCREEN PERFORATED INTERVALS: From 220 ft. to 260 ft., From 0 ft. to 0 ft.
GRAVEL PACK INTERVALS: From 0 ft. to 0 ft., From 0 ft. to 0 ft.
From 50 ft. to 260 ft., From 0 ft. to 0 ft.
From 0 ft. to 0 ft., From 0 ft. to 0 ft.

6 GROUT MATERIAL BENTONITE
Grout Intervals: From 0 ft. to 50 ft., From 0 ft. to 0 ft., From 0 ft. to 0 ft.
What is the nearest source of possible contamination: ABANDONED WELL
Direction from well? SOUTHEAST How many feet? 30

FROM	TO	LITHOLOGIC LOG	FROM	TO	PLUGGING INTERVALS
0	20	TOPSOIL FINE - MED SAND			
20	39	MED-COARSE SAND LARGE GRAVEL			
39	75	BLUE SHALE ROCK LAYERS			
75	80	BLUE SHALE SANDSTONE IN LAYERS			
80	160	SANDSTONE CLAY LAYERS			
160	180	SANDSTONE CLAY IN LAYERS			
180	200	SANDSTONE CLAY IN LAYERS			
200	220	SANDSTONE CLAY LAYERS			
220	260	SANDSTONE			

7 CONTRACTOR'S OR LANDOWNER'S CERTIFICATION: This water well was Constructed under my jurisdiction and was completed on (no/day/year) 05/13/93 and this record is true to the best of my knowledge and belief. Kansas Water Well Contractor's License No. 179 This Water Well Record was completed on (no/day/yr) 05/14/93 under the business name of JOE'S WELL SERVICE, INC. by (signature) *Josid Crisk*