

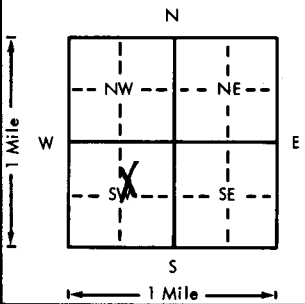
USE TYPEWRITER OR BALL POINT PEN-PRESS FIRMLY, PRINT CLEARLY.

SURFACE WATER

CAC

WATER WELL RECORD  
KSA 82a-1201-1215

Kansas Department of Health and Environment-Division of Environment (Water well Contractors) Topeka, Kansas 66620

1. Location of well:		County <b>Hamilton</b>	Fraction <b>SW 1/4 NE 1/4 SW 1/4 8</b>	Section number <b>8</b>	Township number <b>T 24 S R 42</b>	Range number <b>42</b>
2. Distance and direction from nearest town or city: <b>100 yds. south of bridge 3 8/10 east, 2 8/10 south, 1/2 northeast, 1/2 east of Coolidge</b>				3. Owner of well: <b>Keith Scott</b> R.R. or street: <b>Syracuse, KS 67878</b> City, state, zip code:		
4. Locate with "X" in section below: 				Sketch map:		
5. Type and color of material				From	To	6. Bore hole dia. <b>26</b> in. Completion date <b>11-1-76</b> Well depth <b>130</b> ft.
<b>BROCK 130'</b>						7. <input type="checkbox"/> Cable tool <input type="checkbox"/> Rotary <input type="checkbox"/> Driven <input type="checkbox"/> Dug <input type="checkbox"/> Hollow rod <input type="checkbox"/> Jetted <input type="checkbox"/> Bored <input checked="" type="checkbox"/> Reverse rotary
						8. Use: <input type="checkbox"/> Domestic <input type="checkbox"/> Public supply <input type="checkbox"/> Industry <input checked="" type="checkbox"/> Irrigation <input type="checkbox"/> Air conditioning <input type="checkbox"/> Stock <input type="checkbox"/> Lawn <input type="checkbox"/> Oil field water <input type="checkbox"/> Other
						9. Casing: Material <b>steel</b> Height: Above or below Threaded <input type="checkbox"/> Welded <input checked="" type="checkbox"/> Surface <b>12</b> in. RMP <input type="checkbox"/> PVC <input type="checkbox"/> Weight <b>36.87</b> lb/ft. Dia. <b>16</b> in. to <b>131</b> ft. depth Wall Thickness: inches or Dia. <input type="checkbox"/> in. to <input type="checkbox"/> ft. depth gage No. <input type="checkbox"/>
						10. Screen: Manufacturer's name <b>Johnson</b> Type <b>Galv.</b> Dia. <b>16"</b> Slot/gauze <input type="checkbox"/> Length <b>20'</b> Set between <b>95</b> ft. and <b>125</b> ft. <b>Perf: 60-95</b> ft. and <b>125-130</b> ft. Gravel pack? <b>Yes</b> Size range of material <b>1/2" Down</b>
						11. Static water level: <b>41</b> ft. below land surface Date <b>10-5-76</b> mo./day/yr.
						12. Pumping level below land surfaces: <b>49</b> ft. after <b>3</b> hrs. pumping <b>1350</b> g.p.m. <input type="checkbox"/> ft. after <input type="checkbox"/> hrs. pumping <input type="checkbox"/> g.p.m. Estimated maximum yield <b>1350</b> g.p.m.
						13. Water sample submitted: <input type="checkbox"/> Yes <input checked="" type="checkbox"/> No Date <input type="checkbox"/> mo./day/yr.
						14. Well head completion: <input type="checkbox"/> Pitless adapter <b>12</b> inches above grade
						15. Well grouted? <b>yes</b> With: <input type="checkbox"/> Neat cement <input type="checkbox"/> Bentonite <input checked="" type="checkbox"/> Concrete Depth: From <b>0</b> ft. to <b>10</b> ft.
						16. Nearest source of possible contamination: <b>N/A</b> ft. <input type="checkbox"/> Direction <input type="checkbox"/> Type <b>Field MHC</b> Well disinfected upon completion? <input type="checkbox"/> Yes <input checked="" type="checkbox"/> No
						17. Pump: <input type="checkbox"/> Not installed Manufacturer's name <b>Goulds U.S. Pumps</b> Model number <b>12 JLO</b> HP <b>60</b> Volts <input type="checkbox"/> Length of drop pipe <b>100</b> ft. capacity <b>1000</b> g.p.m. Type: <input type="checkbox"/> Submersible <input checked="" type="checkbox"/> Turbine <input type="checkbox"/> Jet <input type="checkbox"/> Reciprocating <input type="checkbox"/> Centrifugal <input type="checkbox"/> Other
(Use a second sheet if needed)						
18. Elevation:	19. Remarks: <b>3740 (10/70)</b> <b>60 HP electric motor &amp; panel - partwind</b>		20. Water well contractor's certification: This well was drilled under my jurisdiction and this report is true to the best of my knowledge and belief. <b>Minter Wilson Drilling 208</b> Business name License No. Address <b>Box A Garden City, KS 67841</b> Signed <b>[Signature]</b> Date <b>11-1-76</b> Authorized representative			

24 420 - 8 SW 1/4 SEC 24

*The  
Professionals*

**MINTER-WILSON DRILLING CO.**  
INCORPORATED

Irrigation  
and Domestic  
Water Systems  
Complete Installation  
and Repairing

Phone 276-8269 • P.O. Box 493 • GARDEN CITY, KANSAS 67846

KEITH SCOTT  
HAMILTON COUNTY

Location: SW $\frac{1}{4}$  3-24-42 1/8 of miles south  
Static Water Level- 39'

Test # 2

0	9	Top soil fine
9	13	Brown clay
13	23	Fine to med. sand and gravel
23	130	Coarse gravel
130	140	Shale

T.D. 130'