DURKEE CREEK NE

USE TYPEWRITER OR BALL POINT PEN-PRESS FIRMLY, PRINT CLEARLY.

T	R	EW	sec	1/4	1/4	1/4	No.

WATER WELL RECORD
KSA 82a-1201-1215

ACB

Kansas State Dept. Of Health
(Water Well Contractors)
Forbes-Bldg. 740
Topeka, Kansas 66620

1 Location of well: County	Township name	Fraction	Section number	Town number	Range number
Hamilton	Coolidge	SW¼ of NE¼	3	24 S	43 W

Distance and direction from nearest town or city: 4 mi. south & 1½ mi. west of coolidge

Street address of well location if in city:

3 Owner of well: Oliver B. Palmer

Address: Syracuse, Kansas 67878

Locate with "X" in section below:

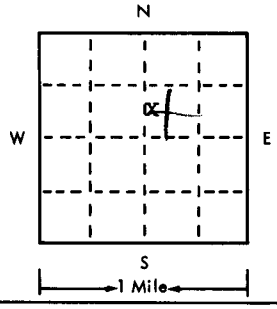

Sketch map:

2 5 Type and color of material	From	To
Overburden	0	32
Sand & Gravel	32	66
Shale	66	68
BROCK 66'		

(use a second sheet if needed)

4 Well depth: 68 ft. Date of completion 7-16-75
Well diameter 26 in.

5 ☐ Cable tool ☐ Rotary ☐ Driven ☐ Dug ☐ Hollow rod ☐ Jetted ☐ Bored ☒ Reverse rotary

6 Use: ☐ Domestic ☐ Public supply ☐ Industry ☒ Irrigation ☐ Air conditioning ☐ Commercial ☐ Test well ☐

7 Casing: Material steel Height: above ~~XXXXX~~ Surface 12 in.
Threaded ☐ Welded ☒
Diam. Weight ___ lbs./ft.
0 in. to 28 ft. depth Drive shoe? ☐ Yes ☒ No
___ in. to ___ ft. depth

8 Screen:
Manufacturer W. A. Brown
Type Free Flo Dia. 16
Slot/gauze slot Length 2"
Set between 28 ft. and 68 ft.
Fittings:
Gravel pack ☒ Yes ☐ No Size range of material 5/8

9 Static water level:
34 ft. below land surface Date 7-16-75

10 Pumping level below land surfaces:
64 ft. after 4 hrs. pumping 1400 g.p.m.
___ ft. after ___ hrs. pumping ___ g.p.m.
Estimated maximum yield 2000 g.p.m.

11 Water sample submitted:
☐ Yes ☒ No Date ___

12 Well head completion:
☐ Pitless adapter ☒ Inches above grade

13 Well grouted? ☒ Yes ☐ No
☐ Neat cement ☒ Bentonite ☐
Depth: From 0 ft. to 10 ft.

14 Nearest source of possible contamination:
ft. ___ Direction ___ Type None
Well disinfected upon completion? ☐ Yes ☒ No

15 Pump: ☒ Not installed
Manufacturer's name
Model number ___ HP ___ Volts ___
Length of drop pipe ___ ft. capacity ___ g.m.p.
Type:
☐ Submersible ☐ Turbine
☐ Jet ☐ Reciprocating
☐ Centrifugal ☐ Other

16 Remarks: elevation Sand hills
3379 (TOPO).

Topography:
☐ Hill
☐ Slope
☐ Upland
☐ Valley

17 Water well contractor's certification:
This well was drilled under my jurisdiction and this report is true to the best of my knowledge and belief.
Ark Valley Pump & Supply 123
Business name License No.
Address 205 S. First
Signed Wm Smith Date 9-2-75
Authorized representative

24 43 W 3 NW SW NE

Forward the white, blue and pink copies to the Kansas State Dept. Of Health.

Form WWC-5