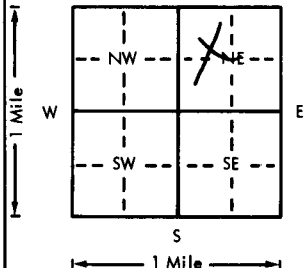


USE TYPEWRITER OR BALL
POINT PEN-PRESS FIRMLY,
PRINT CLEARLY.

WATER WELL RECORD
KSA 82a-1201-1215

Kansas Department of Health and
Environment-Division of Environment
(Water well Contractors)
Topeka, Kansas 66620

ABD

1. Location of well:		County Hamilton	Fraction SE 1/4 NW 1/4 NE 1/4	Section number 11	Township number T 24 S	Range number R 43
2. Distance and direction from nearest town or city: 3 1/2 south 1/4 east 3/4 south of Coolidge Street address of well location if in city:				3. Owner of well: Clifford Low R.R. or street: Coolidge, KS 67836 City, state, zip code:		
4. Locate with "X" in section below: Sketch map: 				6. Bore hole dia. 26 in. Completion date 10-10-76 Well depth 116 ft.		
5. Type and color of material				7. <input type="checkbox"/> Cable tool <input type="checkbox"/> Rotary <input type="checkbox"/> Driven <input type="checkbox"/> Dug <input type="checkbox"/> Hollow rod <input type="checkbox"/> Jetted <input type="checkbox"/> Bored <input checked="" type="checkbox"/> Reverse rotary		
				8. Use: <input type="checkbox"/> Domestic <input type="checkbox"/> Public supply <input type="checkbox"/> Industry <input checked="" type="checkbox"/> Irrigation <input type="checkbox"/> Air conditioning <input type="checkbox"/> Stock <input type="checkbox"/> Lawn <input type="checkbox"/> Oil field water <input type="checkbox"/> Other		
				9. Casing: Material steel Height: Above or below Threaded <input type="checkbox"/> Welded <input checked="" type="checkbox"/> Surface 12 in. RMP <input type="checkbox"/> PVC <input type="checkbox"/> Weight 36.87 lbs./ft. Dia. 16 in. to 117 ft. depth Wall Thickness: inches or Dia. <input type="checkbox"/> in. to <input type="checkbox"/> ft. depth gage No. <input type="checkbox"/>		
				10. Screen: Manufacturer's name Johnson Type Galv. Dia. 16" Slot/gauze <input type="checkbox"/> Length 20' Set between 82 ft. and 112 ft. Perf: 50-82 ft. and 112-116 ft. Gravel pack <input checked="" type="checkbox"/> Size range of material 1/2" Down		
				11. Static water level: <input type="checkbox"/> mo./day/yr. 42 ft. below land surface Date 10-1-76		
				12. Pumping level below land surfaces: 56 ft. after 3 hrs. pumping 1500 g.p.m. <input type="checkbox"/> ft. after <input type="checkbox"/> hrs. pumping <input type="checkbox"/> g.p.m. Estimated maximum yield 1500 g.p.m.		
				13. Water sample submitted: <input type="checkbox"/> mo./day/yr. Yes <input checked="" type="checkbox"/> No <input type="checkbox"/> Date <input type="checkbox"/>		
				14. Well head completion: <input type="checkbox"/> Pitless adapter 12 inches above grade		
				15. Well grouted? yes With: <input type="checkbox"/> Neat cement <input type="checkbox"/> Bentonite <input checked="" type="checkbox"/> Concrete Depth: From 0 ft. to 10 ft.		
				16. Nearest source of possible contamination: N/A ft. <input type="checkbox"/> Direction <input type="checkbox"/> Type Field Well disinfected upon completion? <input type="checkbox"/> Yes <input checked="" type="checkbox"/> No		
(Use a second sheet if needed)				17. Pump: Not installed Manufacturer's name Goolds U.S. Pumps Model number 12 JLO HP 60 Volts <input type="checkbox"/> Length of drop pipe 100 ft. capacity 1000 g.p.m. Type: <input type="checkbox"/> Submersible <input checked="" type="checkbox"/> Turbine <input type="checkbox"/> Jet <input type="checkbox"/> Reciprocating <input type="checkbox"/> Centrifugal <input type="checkbox"/> Other		
18. Elevation:	19. Remarks: 60 HP electric motor & panel		20. Water well contractor's certification: This well was drilled under my jurisdiction and this report is true to the best of my knowledge and belief. Minter Wilson Drilling 208 Business name License No. 67846 Address Box A Garden City, KS Signed Robert L. Simpson Date 10-24-76 Authorized representative			

24 430 11 SE 1/4 NE

DURKEE CREEK NE

The Professionals

METER-WILSON DRILLING CO.
INCORPORATED

Irrigation
and Domestic
Water Systems
Complete Installation
and Repairing

Phone 276-8269 • P.O. Box 493 • GARDEN CITY, KANSAS 67846

CLIFFORD LOW

HAMILTON COUNTY

8-27-76

Location: NW 11-24-43 20 Ft. pivot north pivot
Static Water Level- 35-40

Test #3

0	16	Top soil fine
16	24	Brown clay
24	32	Med. coarse gravel
32	95	Coarse Gravel
95	112	Med. sand to med. coarse gravel yellow trace
112	120	Yellow clay
120	124	Shale

T.D. 116

BROCK 112'

ABD