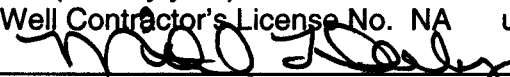


LOCATION OF WATER WELL: RENO	Fraction NE 1/4 SE 1/4 SE 1/4	Section Number 27	Township Number 24 SOUTH	Range Number 05 WEST																				
Distance and direction from nearest town or city street address of well if located within city? APPROXIMATELY 30 NORTH AND 40 WEST OF THE INTERSECTION OF K-96 HIGHWAY AND OBEE ROAD EB237-C																								
WATER WELL OWNER: EQUUS BEDS GMD2																								
RR#, St. Address, Box #: City, State, ZIP Code:		313 SPRUCE STREET HALSTEAD KS 67056-1925 Board of Agriculture, Division of Water Resources Application Number: NA																						
MARK WELL'S LOCATION WITH AN "X" IN SECTION BOX <div style="text-align: center;">N <table border="1" style="margin: auto; border-collapse: collapse;"><tr><td style="width: 50px; height: 50px;"></td><td style="width: 50px; height: 50px;"></td></tr><tr><td style="width: 50px; height: 50px;"></td><td style="width: 50px; height: 50px;"></td></tr><tr><td colspan="2" style="text-align: center;">EB237C - X</td></tr><tr><td colspan="2" style="text-align: center;">S</td></tr></table></div>						EB237C - X		S		DEPTH OF WELL 45.0 ft. WELL'S STATIC WATER LEVEL 19.4 ft. WELL WAS USED AS: <table style="width:100%;"><tr><td>1 Domestic</td><td>5 Public Water Supply</td><td>9 Dewatering</td></tr><tr><td>2 Irrigation</td><td>6 Oil Field Water Supply</td><td>10 Monitoring Well</td></tr><tr><td>3 Feedlot</td><td>7 Lawn and Garden Only</td><td>11 Injection Well</td></tr><tr><td>4 Industrial</td><td>8 Air Conditioning</td><td>12 Other</td></tr></table> Was a chemical/bacteriological sample submitted to Department? Yes <input type="checkbox"/> No <input checked="" type="checkbox"/> If yes, mo/day/yr sample was submitted : / / WaterWell Disinfected: Yes <input type="checkbox"/> No <input checked="" type="checkbox"/>			1 Domestic	5 Public Water Supply	9 Dewatering	2 Irrigation	6 Oil Field Water Supply	10 Monitoring Well	3 Feedlot	7 Lawn and Garden Only	11 Injection Well	4 Industrial	8 Air Conditioning	12 Other
EB237C - X																								
S																								
1 Domestic	5 Public Water Supply	9 Dewatering																						
2 Irrigation	6 Oil Field Water Supply	10 Monitoring Well																						
3 Feedlot	7 Lawn and Garden Only	11 Injection Well																						
4 Industrial	8 Air Conditioning	12 Other																						
TYPE OF BLANK CASING USED:																								
<table style="width:100%;"><tr><td>1 Steel</td><td>3 RMP (SR)</td><td>5 Wrought</td><td>7 Fiberglass</td><td>9 Other</td></tr><tr><td>2 PVC</td><td>4 ABS</td><td>6 Asbestos-Cement</td><td>8 Concrete Tile</td><td></td></tr></table>					1 Steel	3 RMP (SR)	5 Wrought	7 Fiberglass	9 Other	2 PVC	4 ABS	6 Asbestos-Cement	8 Concrete Tile											
1 Steel	3 RMP (SR)	5 Wrought	7 Fiberglass	9 Other																				
2 PVC	4 ABS	6 Asbestos-Cement	8 Concrete Tile																					
Blank casing diameter 2.0 in. Was casing pulled? Yes <input checked="" type="checkbox"/> No <input type="checkbox"/> if yes, how much 12.8 ft bls (steel) Casing height above or below land surface 10.1 feet.																								
GROUT PLUG MATERIAL: 1 Neat cement 2 Cement grout 3 Bentonite 4 Other																								
Grout Plug Intervals: From 45.0 ft. to 16.6 ft. , From 16.6 ft. to 0.0 ft. , From ft. to ft.																								
What is the nearest source of possible contamination:																								
<table style="width:100%;"><tr><td>1 Septic tank</td><td>6 Seepage pit</td><td>11 Fuel Storage</td><td>16 Other - Railroad</td></tr><tr><td>2 Sewer lines</td><td>7 Pit privy</td><td>12 Fertilizer storage</td><td></td></tr><tr><td>3 Watertight sewer lines</td><td>8 Sewage lagoon</td><td>13 Insecticide storage</td><td></td></tr><tr><td>4 Lateral lines</td><td>9 Feedyard</td><td>14 Abandoned water well</td><td></td></tr><tr><td>5 Cess Pool</td><td>10 Livestock pens</td><td>15 Oil well / Gas well</td><td></td></tr></table>					1 Septic tank	6 Seepage pit	11 Fuel Storage	16 Other - Railroad	2 Sewer lines	7 Pit privy	12 Fertilizer storage		3 Watertight sewer lines	8 Sewage lagoon	13 Insecticide storage		4 Lateral lines	9 Feedyard	14 Abandoned water well		5 Cess Pool	10 Livestock pens	15 Oil well / Gas well	
1 Septic tank	6 Seepage pit	11 Fuel Storage	16 Other - Railroad																					
2 Sewer lines	7 Pit privy	12 Fertilizer storage																						
3 Watertight sewer lines	8 Sewage lagoon	13 Insecticide storage																						
4 Lateral lines	9 Feedyard	14 Abandoned water well																						
5 Cess Pool	10 Livestock pens	15 Oil well / Gas well																						
Direction from well? north How many feet? 100																								
FROM	TO	PLUGGING MATERIALS																						
45.0	16.6	Bentonite																						
16.6	0.0	Bentonite, HolePlug																						
CONTRACTOR'S OR LANDOWNER'S CERTIFICATION: This water well was plugged under my jurisdiction and was completed on (mo/day/year) 11 / 29 / 2001 and this record is true to the best of my knowledge and belief. Kansas Water Well Contractor's License No. NA under the business name of Equus Beds GMD2 by (signature) 																								
INSTRUCTIONS: Use typewriter or ball point pen. <u>Please press firmly and print clearly.</u> Please fill in blanks, and underline or circle the correct answers. Send top three copies to Kansas Department of Health and Environment, Bureau of Water, Topeka, Kansas 66620-0001. Telephone: 913/296-3565. Send one to Water Well Owner and retain one for your records.																								

INSTRUCTIONS: Use typewriter or ball point pen. Please press firmly and print clearly. Please fill in blanks, underline or circle the correct answers. Send top three copies to Kansas Department of Health & Environment, Bureau of Water, Topeka, Kansas 66620-0001. Telephone: 785/296-3565. Send one to Water Well Owner and retain one for your records.