

WATER WELL RECORD

Form WWC-5


Division of Water Resources App. No.

[Empty box]

1 LOCATION OF WATER WELL: County: Reno, Fraction: 1/4 NE 1/4 NE 1/4 NW 1/4, Section Number: 32, Township No. T 24 S, Range Number R 5 E W

Street/Rural Address of Well Location; if unknown, distance & direction from nearest town or intersection: If at owner's address, check here [X]. Global Positioning System (GPS) information: Latitude, Longitude, Elevation, Datum, Collection Method.

2 WATER WELL OWNER: RR#, Street Address, Box #: RR#, Street Address, Box #: 11009 S Hornet, City, State, ZIP Code: Hutch, KS 67501

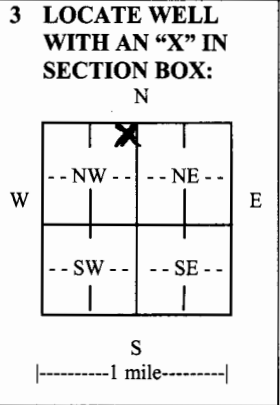

3 LOCATE WELL WITH AN "X" IN SECTION BOX: 4 DEPTH OF COMPLETED WELL 119 ft. Depth(s) Groundwater Encountered (1) 79 ft. (2) 80 ft. (3) 119 ft. WELL'S STATIC WATER LEVEL 79 ft. below land surface measured on mo/day/yr 9-7-10. Pump test data: Well water was 80 ft. after 1 hour pumping 40 gpm. EST. YIELD 40 gpm. Well water was 80 ft. after 1 hour pumping 40 gpm. Bore Hole Diameter 9.5 in. to 3.2 ft., and 5.78 in. to 1.19 ft. WELL WATER TO BE USED AS: [X] Domestic-lawn & garden. Was a chemical/bacteriological sample submitted to Department? [X] No. Water well disinfected? [X] Yes [] No.

5 TYPE OF CASING USED: [X] Steel [] PVC [] Other. CASING JOINTS: [X] Glued [] Clamped [] Welded [] Threaded. Casing diameter 6 in. to 3.2 ft., Diameter 6 in. to 3.2 ft., Diameter 6 in. to 3.2 ft. Casing height above land surface 12 in., Weight 3.32 lbs./ft., Wall thickness or gauge No. 160. TYPE OF SCREEN OR PERFORATION MATERIAL: [X] PVC [] Other (Specify). SCREEN OR PERFORATION OPENINGS ARE: [X] None (open hole). SCREEN-PERFORATED INTERVALS: From 0 ft. to 19 ft., From 19 ft. to 26 ft., From 26 ft. to 119 ft. GRAVEL PACK INTERVALS: From 0 ft. to 19 ft., From 19 ft. to 26 ft., From 26 ft. to 119 ft.

6 GROUT MATERIAL: [] Neat cement [] Cement grout [X] Bentonite [] Other. Grout Intervals: From 2 ft. to 3.2 ft., From 3.2 ft. to 119 ft., From 119 ft. to 119 ft. What is the nearest source of possible contamination: [X] Watertight sewer lines [] Septic tank [] Lateral lines [] Pit privy [] Livestock pens [] Insecticide storage [] Other (specify below). Direction from well NW, Distance from well 200 ft.

Table with columns: FROM, TO, LITHOLOGIC LOG, FROM, TO, LITHO. LOG (cont.) or PLUGGING INTERVALS. Rows: 0-19 Br Clay, 19-26 Rocky Br Clay, 26-119 Shale.

7 CONTRACTOR'S OR LANDOWNER'S CERTIFICATION: This water well was [X] constructed, [] reconstructed, or [] plugged under my jurisdiction and was completed on (mo/day/year) 9-7-10. Kansas Water Well Contractor's License No. 447. This Water Well Record was completed on (mo/day/year) 9-30-10 under the business name of Miller Drilling by (signature) [Signature].

INSTRUCTIONS: Use typewriter or ball point pen. PLEASE PRESS FIRMLY and PRINT clearly. Please fill in blanks and check the correct answers. Send three copies (white, blue, pink) to Kansas Department of Health and Environment, Bureau of Water, Geology Section, 1000 SW Jackson St., Suite 420, Topeka, Kansas 66612-1367. Telephone 785-296-5522. Send one copy to WATER WELL OWNER and retain one for your records. Include fee of \$5.00 for each constructed well. Visit us at http://www.kdheks.gov/waterwell/index.html.