


Southwest of intersection Red Rock Rd. and S. Halstead St. – Yoder

Board of Agriculture, Division of Water Resources

Application Number:

57 ft. ELEVATION:

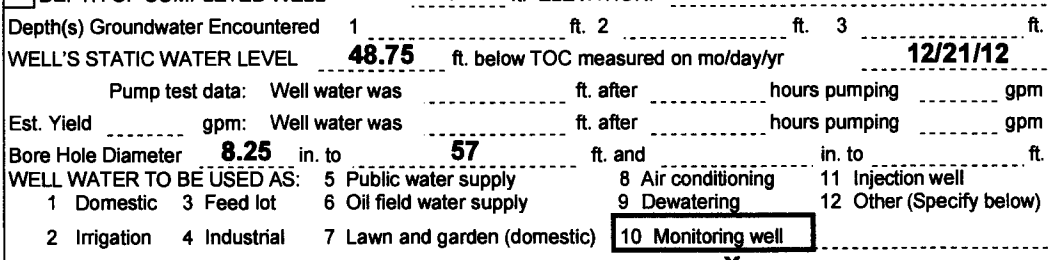

Was a chemical/bacteriological sample submitted to Department? Yes _____ No **X** If yes, mo/day/yr sample was submitted _____
Water Well Disinfected? Yes _____ No **X**

CASING JOINTS: Glued Clamped

9 Other (specify below)

ft., Dia in. to ft.

703

10 Asbestos-cement

8 RMP (SR)

9 ABS

8 Saw cut

9 Drilled holes

0 Other (specify)

m ft. to ft.

m ft. to ft.

m ft. to ft.

m ft. to ft.

3 Bentonite

ft. to

10 Livestock pens

11 Fuel storage

12 Fertilizer storage

13 Insecticide storage

How many feet?

[illegible]

This Water Well Record was completed on (mo/day/yr) **03/01/13**

by (signature)

INSTRUCTIONS: Please fill in blanks and circle the correct answers. Send three copies to Kansas Department of Health and Environment, Bureau of Water, 1000 S W Jackson St., Ste. 420, Topeka, Kansas 66612-1367. Telephone: 913-296-5545. Send one to WATER WELL OWNER and retain one for your records.