

WATER WELL RECORD Form WWC-5 1359885

1359885

Division of Water
Resources App. No.

Well ID


☐ Original Record ☐ Correction ☐ Change in Well Use[illegible]



Legend

- Private Residential Well
- Monitoring Well
- Historic direct push technology (DPT)
- Location

Notes:
Aerial photo date = 7/28/15

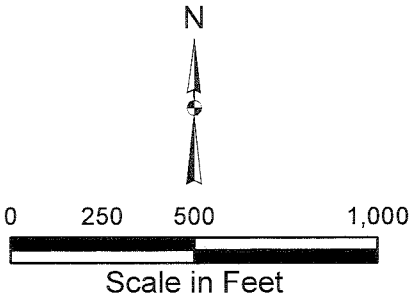

CDM
Smith


US Army Corps
of Engineers ®

Figure 2-2

Site Map

Disposal Trench
Remedial investigation
Former Hutchinson
Naval Air Station