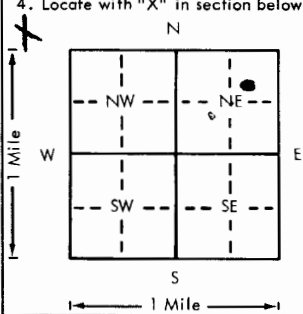
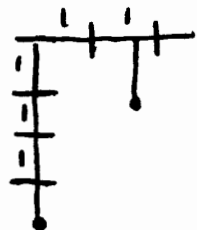


USE TYPEWRITER OR BALL
POINT PEN-PRESS FIRMLY,
PRINT CLEARLY.

WATER WELL RECORD
KSA 82a-1201-1215

Kansas Department of Health and
Environment-Division of Environment
(Water well Contractors)
Topeka, Kansas 66620

1. Location of well:		County Reno	Fraction SW 1/4 NE 1/4 NE 1/4 NE 1/4	Section number 11	Township number T 24 S	Range number R 5 E
2. Distance and direction from nearest town or city: Street address of well location if in city:		2 North of Yoeler 2 E So in field		3. Owner of well: R.R. or street: City, state, zip code:		
				Alan King R.R. 4 Hutchinson, Kansas 67501		
4. Locate with "X" in section below:		Sketch map:		6. Bore hole dia. 8 1/2 in. Completion date 5-21-79 Well depth 30 ft.		
				7. <input checked="" type="checkbox"/> Cable tool <input checked="" type="checkbox"/> Rotary <input type="checkbox"/> Driven <input type="checkbox"/> Dug <input type="checkbox"/> Hollow rod <input type="checkbox"/> Jetted <input type="checkbox"/> Bored <input checked="" type="checkbox"/> Reverse rotary		
5. Type and color of material		From		To		8. Use: <input type="checkbox"/> Domestic <input type="checkbox"/> Public supply <input type="checkbox"/> Industry <input checked="" type="checkbox"/> Irrigation <input type="checkbox"/> Air conditioning <input type="checkbox"/> Stock <input type="checkbox"/> Lawn <input type="checkbox"/> Oil field water <input type="checkbox"/> Other
Top soil		0		3		9. Casing: Material Transite Height: Above or below Threaded <input type="checkbox"/> Welded <input type="checkbox"/> Surface 8 in. RMP <input type="checkbox"/> PVC <input type="checkbox"/> Weight 30 lbs./ft. Dia. 1 1/2 in. to 1 1/2 ft. depth 17 ft. Wall Thickness: inches or Dia. 1 1/2 in. to 1 1/2 ft. depth gage No.
Med. sand		3		23		10. Screen: Manufacturer's name Johnson Type Sawed Dia. 5-21-79 Slot/gauze 3/16 Length 13 Set between 17 ft. and 30 ft. Gravel pack? yes Size range of material 1/4 x 1/4
Med. sand w/clay break		23		24		11. Static water level: 6 ft. below land surface Date 5-21-79 mo./day/yr.
Med. sand		24		27		12. Pumping level below land surfaces: 13 ft. after 1 hrs. pumping 400 g.p.m. 19 ft. after 2 hrs. pumping 400 g.p.m. Estimated maximum yield 650 g.p.m.
Med. sand w/clay break		27		28		13. Water sample submitted: mo./day/yr. <input type="checkbox"/> Yes <input checked="" type="checkbox"/> No Date
Med. sand		28		30		14. Well head completion: Below <input type="checkbox"/> Pitless adapter 36" Inches above grade
						15. Well grouted? yes With: <input type="checkbox"/> Neat cement <input type="checkbox"/> Bentonite <input checked="" type="checkbox"/> Concrete Depth: From 3 ft. to 13 ft.
						16. Nearest source of possible contamination: ft. Direction Type Well disinfected upon completion? <input type="checkbox"/> Yes <input checked="" type="checkbox"/> No
						17. Pump: Not installed Manufacturer's name Berkley Model number 5 x 4 HP 55 Volts Length of drop pipe 20 ft. capacity 400 g.p.m. Type: <input type="checkbox"/> Submersible <input checked="" type="checkbox"/> Turbine <input type="checkbox"/> Jet <input type="checkbox"/> Reciprocating <input checked="" type="checkbox"/> Centrifugal <input type="checkbox"/> Other
18. Elevation:		19. Remarks:		20. Water well contractor's certification: This well was drilled under my jurisdiction and this report is true to the best of my knowledge and belief. Rosencrantz-Bemis Ent. Inc. 134 Business name License No. Address 1211 W. 4th, Hutchinson, Kansas Signed Mike Flowers Date 6-8-79 Authorized representative		

Forward the white, blue and pink copies to the Department of Health and Environment

Form WWC-5