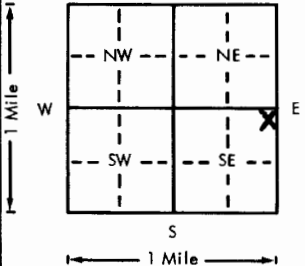
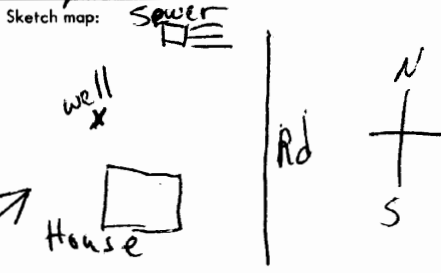


USE TYPEWRITER OR BALL
POINT PEN-PRESS FIRMLY,
PRINT CLEARLY.

WATER WELL RECORD
KSA 82a-1201-1215

Kansas Department of Health and
Environment-Division of Environment
(Water well Contractors)
Topeka, Kansas 66620

1. Location of well:		County Reno	Fraction NE 1/4 NE 1/4 SE 1/4	Section number 16	Township number T 24 S R 5 E W	Range number
2. Distance and direction from nearest town or city: Street address of well location if in city:		1 1/2 mi N Yoder, Ks.		3. Owner of well: R.R. or street: City, state, zip code:		
				Roy Stutzman RT 2 Haven, Ks. 67543		
4. Locate with "X" in section below:		Sketch map:		6. Bore hole dia. 10 in. Completion date 10-17-75 Well depth 66 ft.		
				7. <input checked="" type="checkbox"/> Cable tool <input checked="" type="checkbox"/> Rotary <input type="checkbox"/> Driven <input type="checkbox"/> Dug <input type="checkbox"/> Hollow rod <input type="checkbox"/> Jetted <input type="checkbox"/> Bored <input type="checkbox"/> Reverse rotary		
5. Type and color of material		From		To		8. Use: <input checked="" type="checkbox"/> Domestic <input type="checkbox"/> Public supply <input type="checkbox"/> Industry <input type="checkbox"/> Irrigation <input type="checkbox"/> Air conditioning <input type="checkbox"/> Stock <input type="checkbox"/> Lawn <input type="checkbox"/> Oil field water <input type="checkbox"/> Other
Topsoil		0		4		9. Casing: Material PTST Height: Above or below Threaded <input type="checkbox"/> Welded <input type="checkbox"/> Surface 14 in. RMP <input checked="" type="checkbox"/> PVC <input type="checkbox"/> Weight 195 lbs./ft. Dia. 6 in. to 66 ft. depth Wall thickness: inches or Dia. 6 in. to 66 ft. depth gage No. 200
clay - yellow		4		19		10. Screen: Manufacturer's name Jess + Type RMP Dia. 6" Slot gauge 3/32" Length 10' Set between 56 ft. and 66 ft. Gravel pack? yes size range of material 10-1/2"
clay - reddish yellow		19		37		11. Static water level: 36 ft. below land surface Date 10-17-75 mo./day/yr.
Sand - F - 1/8"		37		66		12. Pumping level below land surfaces: 40 ft. after 1 hrs. pumping 20 g.p.m. ft. after 1 hrs. pumping 20 g.p.m. Estimated maximum yield 40 g.p.m.
						13. Water sample submitted: Yes <input checked="" type="checkbox"/> No <input type="checkbox"/> Date
						14. Well head completion: <input type="checkbox"/> Pitless adapter 14 inches above grade
						15. Well grouted? yes With: <input type="checkbox"/> Neat cement <input type="checkbox"/> Bentonite <input checked="" type="checkbox"/> Concrete Depth: From 0 ft. to 10 ft.
						16. Nearest source of possible contamination: ft. 60 Direction N Type septic Well disinfected upon completion? <input checked="" type="checkbox"/> Yes <input type="checkbox"/> No
						17. Pump: Manufacturer's name Aermotor Not installed Model number SD19 HP 3/4 Volts 230 Length of drop pipe 55 ft. capacity 20 g.p.m. Type: <input checked="" type="checkbox"/> Submersible <input type="checkbox"/> Turbine <input type="checkbox"/> Jet <input type="checkbox"/> Reciprocating <input type="checkbox"/> Centrifugal <input type="checkbox"/> Other
18. Elevation:		19. Remarks:		20. Water well contractor's certification: This well was drilled under my jurisdiction and this report is true to the best of my knowledge and belief. Millen Water well 137 Business name 1539 W 4th Hutchinson License No. Address Ks. 900 Millen Signed 10-17-75 Authorized representative		

Forward the white, blue and pink copies to the Department of Health and Environment

Form WWC-5