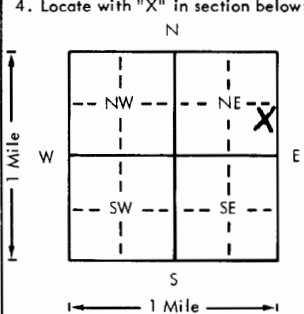


USE TYPEWRITER OR BALL
POINT PEN-PRESS FIRMLY,
PRINT CLEARLY.

WATER WELL RECORD
KSA 82a-1201-1215

Kansas Department of Health and
Environment-Division of Environment
(Water well Contractors)
Topeka, Kansas 66620

1. Location of well:		County Reno	Fraction NE 1/4 SE 1/4 NE 1/4	Section number 16	Township number T 24 S R 5 E	Range number 5
2. Distance and direction from nearest town or city: 1 1/2 mi N of Yoder, Ks.		3. Owner of well: Ray Bontrager R.R. or street: RT 2 City, state, zip code: Haven, Ks. 67543				
4. Locate with "X" in section below:		Sketch map: 			6. Bore hole dia. 10 in. Completed on 5-26-78 Well depth 69 ft.	
					7. <input checked="" type="checkbox"/> Cable tool <input checked="" type="checkbox"/> Rotary <input type="checkbox"/> Driven <input type="checkbox"/> Dug <input type="checkbox"/> Hollow rod <input type="checkbox"/> Jetted <input type="checkbox"/> Bored <input type="checkbox"/> Reverse rotary	
					8. Use: <input checked="" type="checkbox"/> Domestic <input type="checkbox"/> Public supply <input type="checkbox"/> Industry <input type="checkbox"/> Irrigation <input type="checkbox"/> Air conditioning <input type="checkbox"/> Stock <input type="checkbox"/> Lawn <input type="checkbox"/> Oil field water <input type="checkbox"/> Other	
					9. Casing: Material Plst Height: above or below Threaded <input type="checkbox"/> Welded <input type="checkbox"/> Surface 12 in. RMP <input checked="" type="checkbox"/> PVC <input type="checkbox"/> Weight 1.95 lbs./ft. Dia. 6 in. to 69 ft. depth Wall Thickness: inches or Dia. <input type="checkbox"/> in. to <input type="checkbox"/> ft. depth Gauge No. 200	
5. Type and color of material		From		To		10. Screen: Manufacturer's name Sunflower Type RMP Dia. 6" Slot gauge 1060 Length 10' Set between 59 ft. and 69 ft. Gravel pack? yes Size range of material E-1/2"
Topsoil		0		3		11. Static water level: 35 ft. below land surface Date 5-26-78
brown clay		3		40		12. Pumping level below land surfaces: 42 ft. after 1 hrs. pumping 20 g.p.m. ft. after <input type="checkbox"/> hrs. pumping <input type="checkbox"/> g.p.m. Estimated maximum yield 40+ g.p.m.
Sand some gravel last 15'		40		74		13. Water sample submitted: <input checked="" type="checkbox"/> Yes <input type="checkbox"/> No Date <input type="checkbox"/>
						14. Well head completion: <input type="checkbox"/> Pitless adapter 12 inches above grade
						15. Well grouted? yes 1/2 sand With: <input type="checkbox"/> Neat cement <input type="checkbox"/> Bentonite <input checked="" type="checkbox"/> Concrete Depth: From 4 ft. to 14 ft.
						16. Nearest source of possible contamination: Barn Yard ft. 100' Direction NW Type Barn Yard Well disinfected upon completion? <input checked="" type="checkbox"/> Yes <input type="checkbox"/> No
						17. Pump: <input checked="" type="checkbox"/> Not installed Manufacturer's name <input type="checkbox"/> Model number <input type="checkbox"/> HP <input type="checkbox"/> Volts <input type="checkbox"/> Length of drop pipe <input type="checkbox"/> ft. capacity <input type="checkbox"/> g.p.m. Type: <input type="checkbox"/> Submersible <input type="checkbox"/> Turbine <input type="checkbox"/> Jet <input type="checkbox"/> Reciprocating <input type="checkbox"/> Centrifugal <input type="checkbox"/> Other
						20. Water well contractor's certification: This well was drilled under my jurisdiction and this report is true to the best of my knowledge and belief. Miller Water Well 137 Business name Hatchinson, Ks. License No. Address Joe Miller 6-7-78 Signed Joe Miller Date 6-7-78 Authorized representative
18. Elevation:		19. Remarks:				
Topography: <input type="checkbox"/> Hill <input checked="" type="checkbox"/> Slope <input checked="" type="checkbox"/> Upland <input type="checkbox"/> Valley						

Forward the white, blue and pink copies to the Department of Health and Environment

Form WWC-5