


1 LOCATION OF WATER WELL: Fraction SE 1/4 SE 1/4 SE 1/4 Section Number 20 Township Number T 24 S Range Number R 5 E
 County: RENO
 Distance and direction from nearest town or city street address of well if located within city?

1 MILE WEST OF YODER, KS

2 WATER WELL OWNER: ADEN KIEM Board of Agriculture, Division of Water Resources
 RR#, St. Address, Box #: ROUTE 2
 City, State, ZIP Code: HUTCHINSON, KS 67501 Application Number:

3 LOCATE WELL'S LOCATION WITH AN "X" IN SECTION BOX:

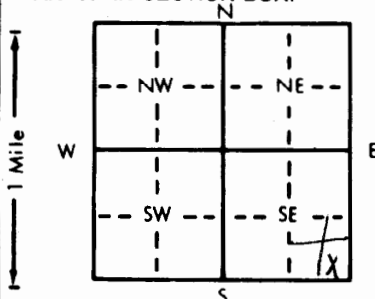

4 DEPTH OF COMPLETED WELL: 60 ft. ELEVATION:

Depth(s) Groundwater Encountered 1. ft. 2. ft. 3. ft.

WELL'S STATIC WATER LEVEL: 2.0 ft. below land surface measured on mo/day/yr 7/21/82

Pump test data: Well water was 2.5 ft. after 3 hours pumping 3.0 gpm

Est. Yield 50 gpm: Well water was ft. after hours pumping gpm

Bore Hole Diameter: 10 in. to 6.3 in. to in. to in.

WELL WATER TO BE USED AS:

1 Domestic 3 Feedlot 6 Oil field water supply 9 Dewatering 11 Injection well

2 Irrigation 4 Industrial 7 Lawn and garden only 10 Observation well

Was a chemical/bacteriological sample submitted to Department? Yes.....No X..... If yes, mo/day/yr sample was submitted

Water Well Disinfected? Yes X No

5 TYPE OF BLANK CASING USED:

1 Steel 3 RMP (SR) 5 Wrought iron 8 Concrete tile CASING JOINTS: Glued X Clamped

2 PVC 4 ABS 6 Asbestos-Cement 9 Other (specify below) Welded

Blank casing diameter 6 in. to 40 ft. Dia. in. to ft. Dia. in. to ft.

Casing height above land surface 2.4 in., weight 3.25 lbs./ft. Wall thickness or gauge No. 160

TYPE OF SCREEN OR PERFORATION MATERIAL:

1 Steel 3 Stainless steel 5 Fiberglass 8 RMP (SR) 10 Asbestos-cement

2 Brass 4 Galvanized steel 6 Concrete tile 9 ABS 11 Other (specify)

SCREEN OR PERFORATION OPENINGS ARE:

1 Continuous slot 3 Mill slot 5 Gauzed wrapped 8 Saw cut 11 None (open hole)

2 Louvered shutter 4 Key punched 6 Wire wrapped 9 Drilled holes

SCREEN-PERFORATED INTERVALS: From 40 ft. to 60 ft., From ft. to ft.

GRAVEL PACK INTERVALS: From 3.5 ft. to 60 ft., From ft. to ft.

FROM ft. to ft., FROM ft. to ft.

FROM ft. to ft., FROM ft. to ft.

7 CONTRACTOR'S OR LANDOWNER'S CERTIFICATION: This water well was (1) constructed, (2) reconstructed, or (3) plugged under my jurisdiction and was completed on (mo/day/year) 7/21/82 and this record is true to the best of my knowledge and belief. Kansas

Water Well Contractor's License No. 431 This Water Well Record was completed on (mo/day/yr) 10-22-83

under the business name of MILLER WATER WELL by (signature) Thom M. A

INSTRUCTIONS: Use typewriter or ball point pen, PLEASE PRESS FIRMLY and PRINT clearly. Please fill in blanks, underline or circle the correct answers. Send top

three copies to Kansas Department of Health and Environment, Division of Environment, Environmental Geology Section, Topeka, KS 66620. Send one to WATER WELL

OWNER and retain one for your records.