

1 LOCATION OF WATER WELL:	Fraction	Section Number	Township Number	Range Number
County: <u>Reno</u>	<u>SE 1/4 SW 1/4 SE 1/4</u>	<u>24</u>	T <u>24</u> S	R <u>5</u> EW


Distance and direction from nearest town or city street address of well if located within city?

3 mi E of Yoder

2 WATER WELL OWNER:	Board of Agriculture, Division of Water Resources
RR#, St. Address, Box # :	Application Number:
City, State, ZIP Code :	

Allen YoderRt 2Haven, KS 67543

3 LOCATE WELL'S LOCATION WITH AN "X" IN SECTION BOX:	4 DEPTH OF COMPLETED WELL <u>134</u> ft. ELEVATION:
--	---

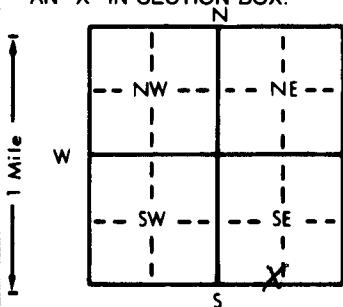

Depth(s) Groundwater Encountered 1. ft. 2. ft. 3. ft.

WELL'S STATIC WATER LEVEL 22 ft. below land surface measured on mo/day/yr 3-17-87Pump test data: Well water was 34 ft. after 1 hours pumping 30 gpmEst. Yield 50 gpm: Well water was ft. after hours pumping gpmBore Hole Diameter 10 in. to 139 ft., and in. to ft.

WELL WATER TO BE USED AS: 5 Public water supply 8 Air conditioning 11 Injection well

① Domestic 3 Feedlot 6 Oil field water supply 9 Dewatering 12 Other (Specify below)

2 Irrigation 4 Industrial 7 Lawn and garden only 10 Observation well

Was a chemical/bacteriological sample submitted to Department? Yes No X If yes, mo/day/yr sample was sub-mitted Water Well Disinfected? Yes X No

5 TYPE OF BLANK CASING USED:	5 Wrought iron	8 Concrete tile	CASING JOINTS: Glued <u>X</u> Clamped
------------------------------	----------------	-----------------	---------------------------------------

1 Steel 3 RMP (SR) 6 Asbestos-Cement 9 Other (specify below) Welded

② PVC 4 ABS 7 Fiberglass Threaded

Blank casing diameter 6 in. to 124 ft., Dia in. to ft., Dia in. to ft.Casing height above land surface 12 in., weight lbs./ft. Wall thickness or gauge No. 200

TYPE OF SCREEN OR PERFORATION MATERIAL: ⑦ PVC 10 Asbestos-cement

1 Steel 3 Stainless steel 5 Fiberglass 8 RMP (SR) 11 Other (specify)

2 Brass 4 Galvanized steel 6 Concrete tile 9 ABS 12 None used (open hole)

SCREEN OR PERFORATION OPENINGS ARE: 5 Gauzed wrapped ⑧ Saw cut 11 None (open hole)

1 Continuous slot 3 Mill slot 6 Wire wrapped 9 Drilled holes

2 Louvered shutter 4 Key punched 7 Torch cut 10 Other (specify)

SCREEN-PERFORATED INTERVALS: From 124 ft. to 134 ft., From ft. to ft.

From ft. to ft., From ft. to ft.

GRAVEL PACK INTERVALS: From 120 ft. to 139 ft., From ft. to ft.

From ft. to ft., From ft. to ft.

6 GROUT MATERIAL:	① Neat cement	2 Cement grout	③ Bentonite	4 Other
-------------------	---------------	----------------	-------------	---------

Grout Intervals: From 4 ft. to 14 ft., From 100 ft. to 110 ft., From ft. to ft.

What is the nearest source of possible contamination: ⑩ Livestock pens 14 Abandoned water well

1 Septic tank 4 Lateral lines 7 Pit privy 11 Fuel storage 15 Oil well/Gas well

2 Sewer lines 5 Cess pool 8 Sewage lagoon 12 Fertilizer storage 16 Other (specify below)

3 Watertight sewer lines 6 Seepage pit 9 Feedyard 13 Insecticide storage

Direction from well? W How many feet? 50

FROM TO LITHOLOGIC LOG FROM TO LITHOLOGIC LOG

0 23 Br Clay

23 29 F Sand

29 35 Gr Clay

35 51 C Sand

51 81 Br Clay

81 88 Sand

88 116 Gr Clay

116 127 Sand-layers Clay

127 134 C Sand

134 139 Gr Clay

7 CONTRACTOR'S OR LANDOWNER'S CERTIFICATION: This water well was ① constructed, (2) reconstructed, or (3) plugged under my jurisdiction and was completed on (mo/day/year) <u>3-17-87</u> and this record is true to the best of my knowledge and belief. Kansas Water Well Contractor's License No. <u>447</u> This Water Well Record was completed on (mo/day/yr) <u>12-29-87</u> under the business name of <u>Miller Drilling</u> by (signature) <u>Emmille</u>

INSTRUCTIONS: Use typewriter or ball point pen. PLEASE PRESS FIRMLY and PRINT clearly. Please fill in blanks, underline or circle the correct answers. Send top three copies to Kansas Department of Health and Environment, Bureau of Water Protection, Topeka, Kansas 66620-7320, Telephone: 913-862-9360. Send one to WATER WELL OWNER and retain one for your records.

OFFICE USE ONLY

T

T

R

S

EW

SEC.

C

4

4

4

4