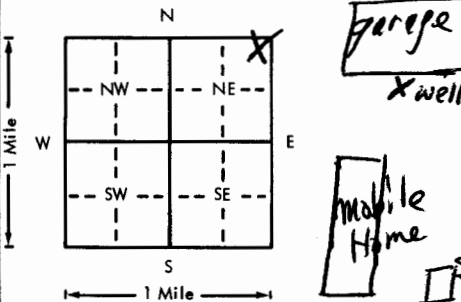


USE TYPEWRITER OR BALL
POINT PEN-PRESS FIRMLY,
PRINT CLEARLY.

WATER WELL RECORD
KSA 82a-1201-1215

Kansas Department of Health and
Environment-Division of Environment
(Water well Contractors)
Topeka, Kansas 66620

1. Location of well:		County <u>Reno</u>	Fraction <u>NE 1/4 NE 1/4 NE 1/4</u>	Section number <u>28</u>	Township number <u>T 24 S R 5</u>	Range number <u>5</u>
2. Distance and direction from nearest town or city: <u>in town</u>		3. Owner of well: <u>J. D. Bontrager</u>				
Street address of well location if in city: <u>of Yoder, Ks.</u>		R.R. or street: <u>Yoder, Ks. 67585</u>				
City, state, zip code: <u>Yoder, Ks. 67585</u>						
4. Locate with "X" in section below:		Sketch map:		6. Bore hole dia. <u>10</u> in. Completion date <u>2-10-76</u>		
				Well depth <u>64</u> ft.		
				7. <input checked="" type="checkbox"/> Cable tool <input checked="" type="checkbox"/> Rotary <input type="checkbox"/> Driven <input type="checkbox"/> Dug		
				<input type="checkbox"/> Hollow rod <input type="checkbox"/> Jetted <input type="checkbox"/> Bored <input type="checkbox"/> Reverse rotary		
				8. Use: <input checked="" type="checkbox"/> Domestic <input type="checkbox"/> Public supply <input type="checkbox"/> Industry		
				<input type="checkbox"/> Irrigation <input type="checkbox"/> Air conditioning <input type="checkbox"/> Stock		
				<input type="checkbox"/> Lawn <input type="checkbox"/> Oil field water <input type="checkbox"/> Other		
				9. Casing: Material <u>PVC</u> Height <u>above</u> or below		
				Threaded <input type="checkbox"/> Welded <input type="checkbox"/> Surface <u>12</u> in.		
				RMP <input checked="" type="checkbox"/> PVC <input type="checkbox"/> Weight <u>195</u> lbs./ft.		
				Dia. <u>6</u> in. to <u>64</u> ft. depth Wall Thickness: inches or		
				Dia. <u>6</u> in. to <u>64</u> ft. depth gage No. <u>200</u>		
5. Type and color of material		From		To		10. Screen: Manufacturer's name <u>JAL</u>
<u>Topsoil drk brown</u>		<u>0</u>		<u>3</u>		Type <u>RMP</u> Dia. <u>6"</u>
<u>clay brown</u>		<u>3</u>		<u>8</u>		Slit/gauze <u>3/32"</u> Length <u>10'</u>
<u>clay yellow w/ white rock</u>		<u>8</u>		<u>27</u>		Set between <u>54</u> ft. and <u>64</u> ft.
<u>Sand - F</u>		<u>27</u>		<u>32</u>		ft. and <u>64</u> ft.
<u>Sand + gravel</u>		<u>32</u>		<u>64</u>		Gravel pack? <u>yes</u> Size range of material <u>F-5"</u>
						11. Static water level: <u>38</u> ft. below land surface Date <u>2-10-76</u>
						12. Pumping level below land surfaces:
						<u>42</u> ft. after <u>1</u> hrs. pumping <u>18</u> g.p.m.
						<u> </u> ft. after <u> </u> hrs. pumping <u> </u> g.p.m.
						Estimated maximum yield <u>35</u> g.p.m.
						13. Water sample submitted: <u> </u> mo./day/yr.
						<u> </u> Yes <input checked="" type="checkbox"/> No <input type="checkbox"/> Date <u> </u>
						14. Well head completion:
						<u> </u> Pitless adapter <u>12</u> inches above grade
						15. Well grouted? <u>yes</u>
						With: <input checked="" type="checkbox"/> Neat cement <input type="checkbox"/> Bentonite <input type="checkbox"/> Concrete
						Depth: From <u>0</u> ft. to <u>10</u> ft.
						16. Nearest source of possible contamination: <u>Tight</u>
						ft. <u>30</u> Direction <u>S</u> Type <u>search</u>
						Well disinfected upon completion? <input checked="" type="checkbox"/> Yes <input type="checkbox"/> No
						17. Pump: <u> </u> Not installed
						Manufacturer's name <u>Valley</u>
						Model number <u>S1208</u> HP <u>5</u> Volts <u>230</u>
						Length of drop pipe <u>50</u> ft. capacity <u>12</u> g.p.m.
						Type:
						<input checked="" type="checkbox"/> Submersible <input type="checkbox"/> Turbine
						<input type="checkbox"/> Jet <input type="checkbox"/> Reciprocating
						<input type="checkbox"/> Centrifugal <input type="checkbox"/> Other
18. Elevation:		19. Remarks:		20. Water well contractor's certification:		
Topography:				This well was drilled under my jurisdiction and this report		
<input type="checkbox"/> Hill				is true to the best of my knowledge and belief.		
<input checked="" type="checkbox"/> Slope				<u>Miller Water Well Serv. 137</u>		
<input checked="" type="checkbox"/> Upland				Business name <u>Hutchinson, Ks.</u> License No. <u> </u>		
<input type="checkbox"/> Valley				Address <u>Geo Miller</u> Date <u>2-15-76</u>		
				Signed <u>Geo Miller</u> Authorized representative		

Forward the white, blue and pink copies to the Department of Health and Environment

Form WWC-5