


WATER WELL RECORD Form WWC-5 KSA 82a-1212

Distance and direction from nearest town or city street address of well if located within city?

2 WATER WELL OWNER: Tom Egly

3 LOCATE WELL'S LOCATION WITH 4 DEPTH OF COMPLETED WELL 64 ft. ELEVATION:

WELL'S STATIC WATER LEVEL 38 ft. below land surface measured on mo/day/yr .. 1-14-87

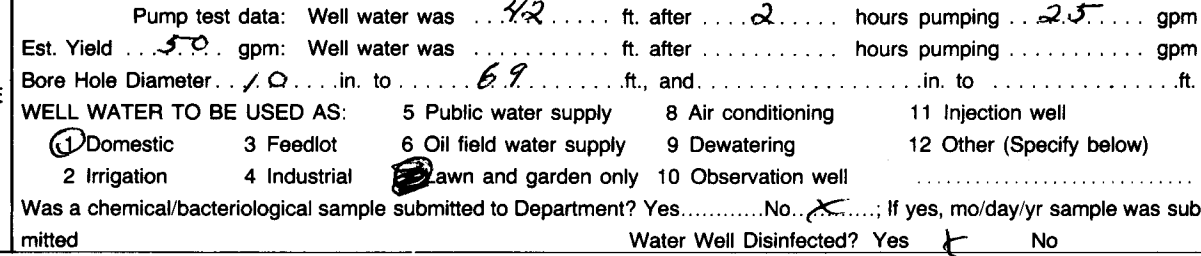

1 Steel	3 RMP (SR)	6 Asbestos-Cement	9 Other (specify below)	Welded
2 PVC	4 ABS	7 Fiberglass		Fiberglass

Casing height above land surface. . . 12 . . . in., weight . . . 3.25 . . . lbs./ft. Wall thickness or gauge No. 160 . . .

1 Steel	3 Stainless steel	5 Fiberglass	8 RMP (SR)	11 Other (specify)
---------	-------------------	--------------	------------	--------------------------

1 Continuous slot	3 Mill slot	5 Glazed wrapped	7 Saw cut	11 None (open hole)
		6 Wire wrapped	9 Drilled holes	

SCREEN-PERFORATED INTERVALS: From 54 ft. to 64 ft., From _____ ft. to _____ ft.

GRAVEL PACK INTERVALS: From 5.0 ft. to 6.0 ft., From _____ ft. to _____ ft.

Grout Intervals: From 3 ft to 13 ft

① Septic tank 4 Lateral lines 7 Pit privy 11 Fuel storage 15 Oil well/Gas well

3 Waterlight sewer lines	6 Seepage pit	9 Feedyard	13 Insecticide storage
--------------------------	---------------	------------	------------------------

0	53	Pr Clark			
---	----	----------	--	--	--

65	69	Gr. Clay			
----	----	----------	--	--	--

[illegible][illegible][illegible][illegible]

completed on (mo/day/year) 1-14-87 and this record is true to the best of my knowledge and belief. Kansas

under the business name of Miller Drilling by (signature) [Signature]

1

⌘

(1)

E/W

SEC.

3

4

1

1