

CORRECTION(S) TO WATER WELL RECORD (WWC-5)

(to rectify lacking or incorrect information)

County:

Reno

Location listed as:

Section-Township-Range: None GivenFraction ($\frac{1}{4}$ $\frac{1}{4}$ $\frac{1}{4}$): _____

Location changed to:

14-245-6WE2 NEOther changes: Initial statements: No GPS datum listedChanged to: Datum: NAD 27

Comments: _____

verification method: Phone call to well contractor, latitude and longitude, and KGS "LEO" conversion tool.

initials:

DRL

date:

11/7/2007

CORRECTION(S) TO WATER WELL RECORD (WWC-5)

(to rectify lacking or incorrect information)

Location listed as:

County:

Reno

Section-Township-Range: None Given

Location changed to:

Fraction ($\frac{1}{4}$ $\frac{1}{4}$ $\frac{1}{4}$):14-24S-6WE2 NE

Other changes: Initial statements:

No GPS datum listed

Changed to:

Datum: NAD 27

Comments:

verification method:

Phone call to well contractor, latitude and longitude, and KGS "LEO" conversion tool.

initials:

date:

DRL 11/7/2007

WATER WELL PLUGGING RECORD Form WWC-5P

KSA 82a-1212

ID NO.

1 LOCATION OF WATER WELL: County: Reno	Fraction $\frac{1}{4}$ $\frac{1}{4}$ $\frac{1}{4}$	Section Number	Township Number	Range Number E/W
---	---	----------------	-----------------	---------------------

Distance and direction from nearest town or city street address of well if located within city?

MW-02**2 WATER WELL OWNER: Empire Gas.**

RR#, St. Address, Box #: 4216 N Sweet Bay Circle

City, State, ZIP Code: Wichita, Ks 67226

Global Positioning System (decimal degrees, min. of 4 digits)

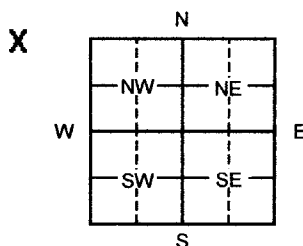
Latitude: 37.96621466667

Longitude: -97.94250916667

Elevation:

Datum:

Data Collection Method:

3 MARK WELL'S LOCATION WITH AN "X" IN SECTION BOX:**4 DEPTH OF WELL** 82 ft.

WELL'S STATIC WATER LEVEL 17 ft

WELL WAS USED AS:

1 Domestic

2 Irrigation

3 Feedlot

4 Industrial

5 Public Water Supply

6 Oil Field Water Supply

7 Domestic (Lawn & Garden)

8 Air Conditioning

9 Dewatering

☒ 10 Monitoring

11 Injection Well

12 Other

Was a chemical/bacteriological sample submitted to Department? Yes ___ No x**5 TYPE OF BLANK CASING USED:**

1 Steel

3 RMP (SR)

5 Wrought

7 Fiberglass

9 Other (Specify below)

☒ 2 PVC

4 ABS

6 Asbestos-Cement

8 Concrete Tile

Blank casing diameter 4 in. Was casing pulled? Yes ___ No x If yes, how much

Casing height above or below land surface 36 in.

6 GROUT PLUG MATERIAL: 1 Neat cement 2 Cement grout ☒ 3 Bentonite 4 OtherGrout Plug Intervals: From ~~24~~ 27 ft. to 3 ft., From ft. to ft., From to ft.

What is the nearest source of possible contamination:

1 Septic tank

6 Seepage pit

11 Fuel Storage

☒ 16 Other (specify below)

2 Sewer lines

7 Pit privy

12 Fertilizer storage

Open field

3 Watertight sewer lines

8 Sewage lagoon

13 Insecticide storage

4 Lateral lines

9 Feedyard

14 Abandoned water well

Direction from well?

5 Cess pool

10 Livestock pens

15 Oil well/Gas well

How many feet?

FROM	TO	PLUGGING MATERIALS	FROM	TO	PLUGGING MATERIALS
24 27	3	bentonite			
3	0	Top soil			

7 CONTRACTOR'S OR LANDOWNER'S CERTIFICATION: This water well was plugged under my jurisdiction and was completed on (mo/day/year) 9-15-07 and this record is true to the best of my knowledge and belief. Kansas Water Well Contractor's License No. 740. This Water Well Record was completed on (mo/day/year) 9-20-07 under the business name of Weninger Drilling Inc. by (signature) _____.

INSTRUCTIONS: Please fill in blanks or circle the correct answers. Send top three copies to Kansas Department of Health and Environment, Bureau of Water, Geology Section, 1000 SW Jackson St., Ste. 420, Topeka, Kansas 66612-1367. Telephone: 785/296-5522. Send one to Water Well Owner and retain one for your records. Visit us at <http://www.kdheks.gov/waterwell>.

White Copy

KSA 82a-1212

Form provided by Forms-On-A-Disk, Inc. • Dallas, Texas • (214) 340-9429