

CORRECTION(S) TO WATER WELL RECORD (WWC-5)

(to rectify lacking or incorrect information)

Location listed as:

Section-Township-Range: None Given

Fraction ($\frac{1}{4}$ $\frac{1}{4}$ $\frac{1}{4}$): _____

County: Reno

Location changed to:

14-24S-6W

W2 E2 W2 NE

Other changes: Initial statements: No GPS datum listed

Changed to: Datum: NAD 27

Comments: _____

verification method: Phone call to well contractor, latitude and longitude, and KGS "LEO" conversion tool.

initials: DR date: 11/7/2007

submitted by: Kansas Geological Survey, Data Resources Library, 1930 Constant Ave., Lawrence, KS 66047-3726
to: Kansas Dept of Health & Environment, Bureau of Water, 1000 SW Jackson, Suite 420, Topeka, KS 66612-1367.

WATER WELL PLUGGING RECORD Form WWC-5P

KSA 82a-1212

ID NO.

1 LOCATION OF WATER WELL: County: Reno	Fraction $\frac{1}{4}$ $\frac{1}{4}$ $\frac{1}{4}$	Section Number	Township Number	Range Number E/W
---	---	----------------	-----------------	---------------------

Distance and direction from nearest town or city street address of well if located within city?
MW-04

2 WATER WELL OWNER: Empire Gas.

RR#, St. Address, Box #: 4216 N Sweet Bay Circle

City, State, ZIP Code: Wichita, Ks 67226

Global Positioning System (decimal degrees, min. of 4 digits)

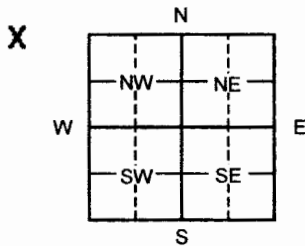
Latitude: 37.96617783333

Longitude: -97.94665900000

Elevation:

Datum:

Data Collection Method:

3 MARK WELL'S LOCATION WITH AN "X" IN SECTION BOX:**4 DEPTH OF WELL 85 ft.**

WELL'S STATIC WATER LEVEL 18 ft

WELL WAS USED AS:

- 1 Domestic
- 2 Irrigation
- 3 Feedlot
- 4 Industrial

- 5 Public Water Supply
- 6 Oil Field Water Supply
- 7 Domestic (Lawn & Garden)
- 8 Air Conditioning

- 9 Dewatering
- 10 Monitoring
- 11 Injection Well
- 12 Other

Was a chemical/bacteriological sample submitted to Department? Yes ___ No x**5 TYPE OF BLANK CASING USED:**

- | | | | | |
|---------|------------|-------------------|-----------------|-------------------------|
| 1 Steel | 3 RMP (SR) | 5 Wrought | 7 Fiberglass | 9 Other (Specify below) |
| 2 PVC | 4 ABS | 6 Asbestos-Cement | 8 Concrete Tile | |

Blank casing diameter 4 in. Was casing pulled? Yes ___ No x If yes, how much

Casing height above or below land surface 36 in.

6 GROUT PLUG MATERIAL: 1 Neat cement 2 Cement grout 3 Bentonite 4 Other

Grout Plug Intervals: From 85 ft. to 3 ft., From ft. to ft., From to ft.

What is the nearest source of possible contamination:

- | | | | |
|--------------------------|-------------------|-------------------------|--------------------------|
| 1 Septic tank | 6 Seepage pit | 11 Fuel Storage | 16 Other (specify below) |
| 2 Sewer lines | 7 Pit privy | 12 Fertilizer storage | Open field |
| 3 Watertight sewer lines | 8 Sewage lagoon | 13 Insecticide storage | |
| 4 Lateral lines | 9 Feedyard | 14 Abandoned water well | Direction from well? |
| 5 Cess pool | 10 Livestock pens | 15 Oil well/Gas well | How many feet? |

FROM	TO	PLUGGING MATERIALS	FROM	TO	PLUGGING MATERIALS
85	3	bentonite			
3	0	Top soil			

7 CONTRACTOR'S OR LANDOWNER'S CERTIFICATION: This water well was plugged under my jurisdiction and was completed on (mo/day/year) 9-15-07 and this record is true to the best of my knowledge and belief. Kansas Water Well Contractor's License No. 740. This Water Well Record was completed on (mo/day/year) 9-20-07 under the business name of Weninger Drilling Inc. by (signature) [Signature]

INSTRUCTIONS: Please fill in blanks or circle the correct answers. Send top three copies to Kansas Department of Health and Environment, Bureau of Water, Geology Section, 1000 SW Jackson St., Ste. 420, Topeka, Kansas 66612-1367. Telephone: 785/296-5522. Send one to Water Well Owner and retain one for your records. Visit us at <http://www.kdheks.gov/waterwell>.

White Copy

KSA 82a-1212

Form provided by Forms-On-A-Disk, Inc. • Dallas, Texas • (214) 340-9429