

CORRECTION(S) TO WATER WELL RECORD (WWC-5)

(to rectify lacking or incorrect information)

County: Reno

Location listed as:

Location changed to:

Section-Township-Range: None Given

14-24S-6W

Fraction ($\frac{1}{4}$ $\frac{1}{4}$ $\frac{1}{4}$): _____

S2 SE SW NE

Other changes: Initial statements: No GPS datum listed

Changed to: Datum: NAD 27

Comments: _____

verification method: Phone call to well contractor, latitude and longitude, and KGS "LEO" conversion tool.

initials: DR date: 11/7/2007

1 LOCATION OF WATER WELL: County: Reno	Fraction $\frac{1}{4}$ $\frac{1}{4}$ $\frac{1}{4}$	Section Number	Township Number	Range Number E/W
---	---	----------------	-----------------	---------------------

Distance and direction from nearest town or city street address of well if located within city?

MW-08**2 WATER WELL OWNER: Empire Gas.**

RR#, St. Address, Box #: 4216 N Sweet Bay Circle

City, State, ZIP Code: Wichita, Ks 67226

Global Positioning System (decimal degrees, min. of 4 digits)

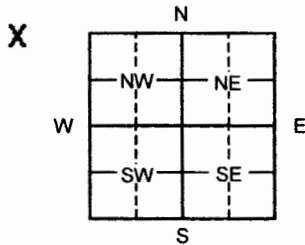
Latitude: 37.96278850000

Longitude: -97.94585233333

Elevation:

Datum:

Data Collection Method:

3 MARK WELL'S LOCATION WITH AN "X" IN SECTION BOX:**4 DEPTH OF WELL 81 ft.**

WELL'S STATIC WATER LEVEL 18 ft

WELL WAS USED AS:

1 Domestic

2 Irrigation

3 Feedlot

4 Industrial

5 Public Water Supply

6 Oil Field Water Supply

7 Domestic (Lawn & Garden)

8 Air Conditioning

9 Dewatering

☒ 10 Monitoring

11 Injection Well

12 Other

Was a chemical/bacteriological sample submitted to Department? Yes ___ No ☒ x**5 TYPE OF BLANK CASING USED:**

1 Steel

3 RMP (SR)

5 Wrought

7 Fiberglass

9 Other (Specify below)

☒ 2 PVC

4 ABS

6 Asbestos-Cement

8 Concrete Tile

Blank casing diameter 4 in. Was casing pulled? Yes ___ No ☒ x If yes, how much

Casing height above or below land surface 36 in.

6 GROUT PLUG MATERIAL: 1 Neat cement 2 Cement grout ☒ 3 Bentonite 4 Other

Grout Plug Intervals: From 81 ft. to 3 ft., From ft. to ft., From to ft.

What is the nearest source of possible contamination:

1 Septic tank

6 Seepage pit

11 Fuel Storage

☒ 16 Other (specify below)

2 Sewer lines

7 Pit privy

12 Fertilizer storage

Open field

3 Watertight sewer lines

8 Sewage lagoon

13 Insecticide storage

4 Lateral lines

9 Feedyard

14 Abandoned water well

Direction from well?

5 Cess pool

10 Livestock pens

15 Oil well/Gas well

How many feet?

FROM	TO	PLUGGING MATERIALS	FROM	TO	PLUGGING MATERIALS
81	3	bentonite			
3	0	Top soil			

7 CONTRACTOR'S OR LANDOWNER'S CERTIFICATION: This water well was plugged under my jurisdiction and was completed on (mo/day/year) 9-15-07 and this record is true to the best of my knowledge and belief. Kansas Water Well Contractor's License No. 740. This Water Well Record was completed on (mo/day/year) 9-20-07 under the business name of Weninger Drilling Inc. by (signature) [Signature]

INSTRUCTIONS: Please fill in blanks or circle the correct answers. Send top three copies to Kansas Department of Health and Environment, Bureau of Water, Geology Section, 1000 SW Jackson St., Ste. 420, Topeka, Kansas 66612-1367. Telephone: 785/296-5522. Send one to Water Well Owner and retain one for your records. Visit us at <http://www.kdheks.gov/waterwell>.