

County: Reno Fraction C NE Sec. 3 T 24 S R 6 EW

CORRECTION(S) TO WATER WELL COMPLETION RECORD (WWC-5)

(to rectify lacking or incorrect information)

Owner: CB Showalter

Location was listed as:

Location changed to:

Section-Township-Range: 30-24S-6W

3-24S-6W

Fraction (1/4 1/4 1/4): NE

C NE

Other changes: Initial statements: _____

Changed to: _____

Comments: _____

Verification method: written description, water rights records in WIMAS database, Reno County online parcel search, and mapping tool & aerial photos on KGS website. initials: ORA date: 6/26/2015

Submitted by: Kansas Geological Survey, Data Resources Library, 1930 Constant Ave., Lawrence, KS 66047-3726
to: Kansas Dept of Health & Environment, Bureau of Water, 1000 SW Jackson, Suite 420, Topeka, KS 66612-1367.

WATER WELL RECORD

Form WWC-5

Division of Water Resources App. No.


36841

1 LOCATION OF WATER WELL: County: Reno	Fraction ¼ ¼ ¼ NE ¼	Section Number 30	Township No. T 24 S	Range Number R 6 <input type="checkbox"/> E <input checked="" type="checkbox"/> W
--	------------------------------	----------------------	------------------------	--

Street/Rural Address of Well Location; if unknown, distance & direction from nearest town or intersection: If at owner's address, check here .
Morgan Ave & Valley Pride Rd

Global Positioning System (GPS) information:
 Latitude: (in decimal degrees)
 Longitude: (in decimal degrees)
 Elevation:
 Datum: WGS 84, NAD 83, NAD 27
 Collection Method:
 GPS unit (Make/Model:)
 Digital Map/Photo, Topographic Map, Land Survey
 Est. Accuracy: <3 m, 3-5 m, 5-15 m, >15 m

2 WATER WELL OWNER: CB Showalter
 RR#, Street Address, Box #: 8803 E. Arlinton Rd
 City, State, ZIP Code : Haven, KS 67543-8211

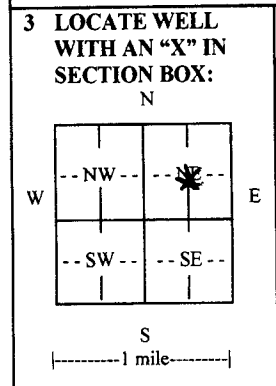

4 DEPTH OF COMPLETED WELL 120 ft.

Depth(s) Groundwater Encountered (1) .32 ft. (2) ft. (3) ft.

WELL'S STATIC WATER LEVEL .32 ft. below land surface measured on mo/day/yr.

Pump test data: Well water was ft. after hours pumping gpm

EST. YIELD .800 gpm. Well water was ft. after hours pumping gpm

Bore Hole Diameter 30 in. to 120 ft., and in. to ft.

WELL WATER TO BE USED AS: Public water supply Geothermal Injection well
 Domestic Feedlot Oil field water supply Dewatering Other (Specify below)
 Irrigation Industrial Domestic-lawn & garden Monitoring well

Was a chemical/bacteriological sample submitted to Department? Yes No

If yes, mo/day/yr sample was submitted.

Water well disinfected? Yes No

5 TYPE OF CASING USED: Steel PVC Other

CASING JOINTS: Glued Clamped Welded Threaded

Casing diameter .16 in. to 120 ft., Diameter in. to ft., Diameter in. to ft.

Casing height above land surface .12 in., Weight .16 lbs./ft., Wall thickness or gauge No. SCH40

TYPE OF SCREEN OR PERFORATION MATERIAL:
 Steel Stainless Steel PVC Other (Specify)
 Brass Galvanized Steel None used (open hole)

SCREEN OR PERFORATION OPENINGS ARE:
 Continuous slot Mill slot Gauze wrapped Torch cut Drilled holes None (open hole)
 Louvered shutter Key punched Wire wrapped Saw cut Other (specify)

SCREEN-PERFORATED INTERVALS: From 80 ft. to 120 ft., From ft. to ft.
 From ft. to ft., From ft. to ft.

GRAVEL PACK INTERVALS: From 20 ft. to 120 ft., From ft. to ft.
 From ft. to ft., From ft. to ft.

6 GROUT MATERIAL: Neat cement Cement grout Bentonite Other

Grout Intervals: From 3 ft. to 20 ft., From ft. to ft., From ft. to ft.

What is the nearest source of possible contamination:
 Septic tank Lateral lines Pit privy Livestock pens Insecticide storage Other (specify below)
 Sewer lines Cesspool Sewage lagoon Fuel storage Abandoned water well
 Watertight sewer lines Seepage pit Feedyard Fertilizer storage Oil well/gas well **OLD WELL**

Direction from well 50 Distance from well West

FROM	TO	LITHOLOGIC LOG	FROM	TO	LITHO. LOG (cont.) or PLUGGING INTERVALS
0	20	Clay			
20	25	Sandy Clay			
25	40	Medium Sand			
40	45	Medium Sand w/Clay layers			
45	62	Medium Sand w/Clay layers			
62	75	Clay			
75	80	Medium Sand w/Clay layers			
80	98	Medium Sand w/Clay layers			
98	107	Clay			
107	120	Medium Sand w/Clay layers			

7 CONTRACTOR'S OR LANDOWNER'S CERTIFICATION: This water well was constructed, reconstructed, or plugged under my jurisdiction and was completed on (mo/day/year) 04/24/2014 and this record is true to the best of my knowledge and belief.

Kansas Water Well Contractor's License No. 238 This Water Well Record was completed on (mo/day/year) 04/28/2014 under the business name of Premier Pump & Well Service, Inc. by (signature) *Morgan Showalter*

INSTRUCTIONS: Use typewriter or ball point pen. PLEASE PRESS FIRMLY and PRINT clearly. Please fill in blanks and check the correct answers. Send one copy to Kansas Department of Health and Environment, Bureau of Water, Geology Section, 1000 SW Jackson St., Suite 420, Topeka, Kansas 66612-1367. Telephone 785-296-5524. Send one copy to WATER WELL OWNER and retain one for your records. Include fee of \$5.00 for each constructed well. Visit us at <http://www.kdheks.gov/waterwell/index.html>