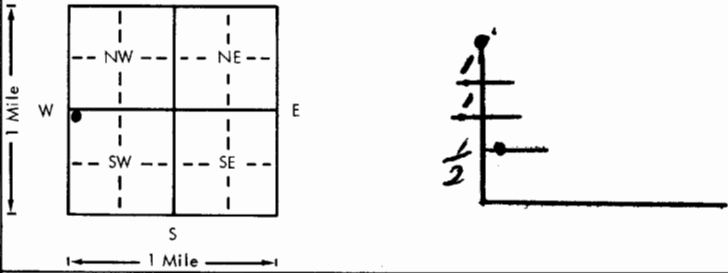


USE TYPEWRITER OR BALL
POINT PEN-PRESS FIRMLY,
PRINT CLEARLY.

WATER WELL RECORD
KSA 82a-1201-1215

Kansas Department of Health and
Environment-Division of Environment
(Water well Contractors)
Topeka, Kansas 66620

1. Location of well: County Reno Fraction NW 1/4 NW 1/4 SW 1/4 Section number 8 Township number T 24 S R 6 Range number E 10																									
2. Distance and direction from nearest town or city: 2 1/2 So of white East in field by road																									
3. Owner of well: David Miller R.R. or street: RFD 1 City, state, zip code: Hutchinson, Kansas 67501																									
4. Locate with "X" in section below: Sketch map: 																									
5. Type and color of material																									
<table border="1"><thead><tr><th>Type and color of material</th><th>From</th><th>To</th></tr></thead><tbody><tr><td>Dark brown clay</td><td>0</td><td>5</td></tr><tr><td>Brown clay</td><td>5</td><td>10</td></tr><tr><td>Med. sand</td><td>10</td><td>20</td></tr><tr><td>Med. sand, Little clay</td><td>20</td><td>30</td></tr><tr><td>Med. sand</td><td>30</td><td>40</td></tr><tr><td>Coarse sand</td><td>40</td><td>45</td></tr><tr><td>Shale</td><td>45</td><td>50</td></tr></tbody></table>		Type and color of material	From	To	Dark brown clay	0	5	Brown clay	5	10	Med. sand	10	20	Med. sand, Little clay	20	30	Med. sand	30	40	Coarse sand	40	45	Shale	45	50
Type and color of material	From	To																							
Dark brown clay	0	5																							
Brown clay	5	10																							
Med. sand	10	20																							
Med. sand, Little clay	20	30																							
Med. sand	30	40																							
Coarse sand	40	45																							
Shale	45	50																							
6. Bore hole dia. 26 in. Completion date 7/30/77 Well depth 46 ft.																									
7. <input type="checkbox"/> Cable tool <input type="checkbox"/> Rotary <input type="checkbox"/> Driven <input type="checkbox"/> Dug <input type="checkbox"/> Hollow rod <input type="checkbox"/> Jetted <input checked="" type="checkbox"/> Bored <input checked="" type="checkbox"/> Reverse rotary																									
8. Use: <input type="checkbox"/> Domestic <input type="checkbox"/> Public supply <input type="checkbox"/> Industry <input checked="" type="checkbox"/> Irrigation <input type="checkbox"/> Air conditioning <input type="checkbox"/> Stock <input type="checkbox"/> Lawn <input type="checkbox"/> Oil field water <input type="checkbox"/> Other																									
9. Casing: Material Transite Height: Above or below Threaded <input type="checkbox"/> Welded <input type="checkbox"/> Surface 8 in. RMP <input type="checkbox"/> PVC <input type="checkbox"/> Weight 30 lbs./ft. Dia. 16 in. to 20 ft. depth Wall Thickness: inches or Dia. 0 in. to 40 ft. depth gage No. 3/16																									
10. Screen: Manufacturer's name Johnson Type sawed Dia. 16 Slot/gauze 3/16 Length 26 Set between 20 ft. and 46 ft. ft. and ft. Gravel pack? yes Size range of material 1/8 - 1/4																									
11. Static water level: 16 ft. below land surface Date 7/30/77																									
12. Pumping level below land surfaces: 30 ft. after 1 hrs. pumping 180 g.p.m. 30 ft. after 1 hrs. pumping 180 g.p.m. Estimated maximum yield 180 g.p.m.																									
13. Water sample submitted: 180 g.p.m. Date 7/30/77 Yes <input checked="" type="checkbox"/> No <input type="checkbox"/>																									
14. Well head completion: 8 inches above grade <input type="checkbox"/> Pitless adapter <input checked="" type="checkbox"/>																									
15. Well grouted? yes With: <input type="checkbox"/> Neat cement <input type="checkbox"/> Bentonite <input checked="" type="checkbox"/> Concrete Depth: From 0 ft. to 10 ft.																									
16. Nearest source of possible contamination: ft. none Direction none Type none Well disinfected upon completion? yes Yes <input checked="" type="checkbox"/> No <input type="checkbox"/>																									
17. Pump: X Not installed Manufacturer's name Darling Model number 189 HP 1 Volts 115 Length of drop pipe 10 ft. capacity 180 g.p.m. Type: <input type="checkbox"/> Submersible <input type="checkbox"/> Turbine <input type="checkbox"/> Jet <input type="checkbox"/> Reciprocating <input type="checkbox"/> Centrifugal <input type="checkbox"/> Other																									
18. Elevation: 1573 Topography: <input type="checkbox"/> Hill <input checked="" type="checkbox"/> Slope <input type="checkbox"/> Upland <input type="checkbox"/> Valley																									
19. Remarks: 29/34																									
20. Water well contractor's certification: This well was drilled under my jurisdiction and this report is true to the best of my knowledge and belief. Darling Drilling Co. 189 Business name Darling Drilling Co. License No. 121 W. 4th Hutchinson, Ks Address 121 W. 4th Hutchinson, Ks Signed Donald J. Darling date 7/30/77 Authorized representative																									

Forward the white, blue and pink copies to the Department of Health and Environment

Form WWC-5