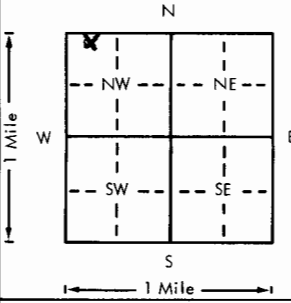


USE TYPEWRITER OR BALL
POINT PEN-PRESS FIRMLY,
PRINT CLEARLY.

WATER WELL RECORD
KSA 82a-1201-1215

Kansas Department of Health and
Environment-Division of Environment
(Water well Contractors)
Topeka, Kansas 66620

1. Location of well:		County Reno	Fraction NW 1/4 NW 1/4 NW 1/4	Section number 11	Township number T 24 S R 6	Range number 6
2. Distance and direction from nearest town or city: 2 mi. South of West of South Hutchinson				3. Owner of well: S City of South Hutchinson R.R. or street: South Hutchinson City, state, zip code: Kansas 67501		
4. Locate with "X" in section below:		Sketch map:		6. Bore hole dia. 30 in. Completion date 10/24/78 Well depth 139 ft.		
		Well No. 2 Test Hole 2-78		7. <input type="checkbox"/> Cable tool <input type="checkbox"/> Rotary <input type="checkbox"/> Driven <input type="checkbox"/> Dug <input type="checkbox"/> Hollow rod <input type="checkbox"/> Jetted <input type="checkbox"/> Bored <input checked="" type="checkbox"/> Reverse rotary		
5. Type and color of material		From	To	8. Use: <input type="checkbox"/> Domestic <input checked="" type="checkbox"/> Public supply <input type="checkbox"/> Industry <input type="checkbox"/> Irrigation <input type="checkbox"/> Air conditioning <input type="checkbox"/> Stock <input type="checkbox"/> Lawn <input type="checkbox"/> Oil field water <input type="checkbox"/> Other		
Soil		0	3	9. Casing: Material STL Height: Above 42 in. Threaded <input type="checkbox"/> Welded <input checked="" type="checkbox"/> Surface 42 in. RMP <input type="checkbox"/> PVC <input type="checkbox"/> Weight 62.58 lbs./ft. Dia. 16 in. to 117 ft. depth Wall Thickness: inches or Dia. 16 in. to 117 ft. depth gage No. 375		
Brown clay		3	18	10. Screen: Manufacturer's name Layne & Bowler Type St. Steel Dia. 16" Slot/gauge 105 Length 25' Set between 114 ft. and 139 ft. Gravel pack? Yes Size range of material 1/4 x 1/8		
Med. to coarse sand		18	26	11. Static water level: 21 ft. below land surface Date 11/2/78		
Tan clay		26	40	12. Pumping level below land surfaces: 63 ft. after 8 hrs. pumping 900 g.p.m. ____ ft. after ____ hrs. pumping ____ g.p.m. Estimated maximum yield 1200 g.p.m.		
Med. to coarse sand		40	56	13. Water sample submitted: Yes <input checked="" type="checkbox"/> No <input type="checkbox"/> Date ____		
Tan clay		56	75	14. Well head completion: <input type="checkbox"/> Pitless adapter 42 Inches above grade		
Fine to coarse sand		75	98	15. Well grouted? Yes With: <input type="checkbox"/> Neat cement <input type="checkbox"/> Bentonite <input checked="" type="checkbox"/> Concrete Depth: From 0 ft. to 20 ft.		
Tan clay w/fine sand streaks		98	108	16. Nearest source of possible contamination: ft. 1800 Direction East Type Farm Well disinfected upon completion? <input checked="" type="checkbox"/> Yes <input type="checkbox"/> No		
Med. to coarse sand & fine gravel		108	138	17. Pump: <input type="checkbox"/> Not installed Manufacturer's name Layne & Bowler Model number 11B HP 60 Volts 460 Length of drop pipe 120 ft. capacity 700 g.p.m. Type: <input type="checkbox"/> Submersible <input checked="" type="checkbox"/> Turbine <input type="checkbox"/> Jet <input type="checkbox"/> Reciprocating <input type="checkbox"/> Centrifugal <input type="checkbox"/> Other		
(Use a second sheet if needed)				20. Water well contractor's certification: This well was drilled under my jurisdiction and this report is true to the best of my knowledge and belief. Layne Western Co. 102 Business name License No. Address Topeka, Kansas Signed [Signature] Date 11/6/78 Authorized representative		
18. Elevation:		19. Remarks:				
Topography: <input type="checkbox"/> Hill <input type="checkbox"/> Slope <input checked="" type="checkbox"/> Upland <input type="checkbox"/> Valley						

Forward the white, blue and pink copies to the Department of Health and Environment

Form WWC-5