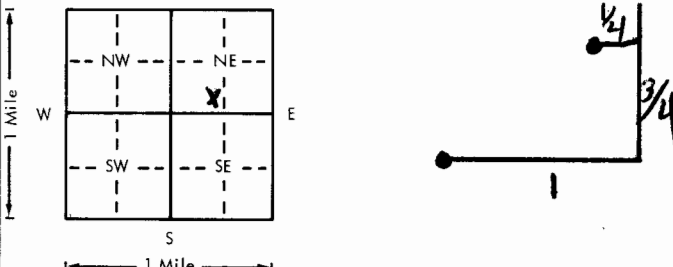


USE TYPEWRITER OR BALL
POINT PEN—PRESS FIRMLY,
PRINT CLEARLY.

WATER WELL RECORD
KSA 82a-1201-1215

Kansas Department of Health and
Environment—Division of Environment
(Water well Contractors)
Topeka, Kansas 66620

1. Location of well:	County Reno	Fraction SE 1/4 SW 1/4 NE 1/4	Section number 12	Township number T 24 S R 6 E	Range number 6
2. Distance and direction from nearest town or city: Street address of well location if in city:	1 mile East Elmer 3/4 N. west in field		3. Owner of well: R.R. or street: City, state, zip code:		
4. Locate with "X" in section below: Sketch map:			6. Bore hole dia. 8 1/2 in. Completion date 4/30/79 Well depth 120 ft.		
			7. <input type="checkbox"/> Cable tool <input type="checkbox"/> Rotary <input type="checkbox"/> Driven <input type="checkbox"/> Dug <input type="checkbox"/> Hollow rod <input type="checkbox"/> Jetted <input type="checkbox"/> Bored <input checked="" type="checkbox"/> Reverse rotary		
5. Type and color of material			8. Use: <input type="checkbox"/> Domestic <input type="checkbox"/> Public supply <input type="checkbox"/> Industry <input checked="" type="checkbox"/> Irrigation <input type="checkbox"/> Air conditioning <input type="checkbox"/> Stock <input type="checkbox"/> Lawn <input type="checkbox"/> Oil field water <input type="checkbox"/> Other		
			9. Casing: Material Transite Height: Above or below Threaded <input type="checkbox"/> Welded <input type="checkbox"/> Surface 8 in. RMP <input type="checkbox"/> PVC <input type="checkbox"/> Weight 30 lbs./ft. Dia. 16 in. to 81 ft. depth Wall Thickness: inches Dia. 0 in. to 81 ft. depth gauge No. 3/16 7/4		
			10. Screen: Manufacturer's name Johnson Type sawed Dia. 16 Slot/gauze 3/16 Length 39 Set between 81 ft. and 120 ft. ft. and ft. Gravel pack? yes Size range of material 1/8-1/4		
			11. Static water level: 19 ft. below land surface Date 4/30/79		
			12. Pumping level below land surfaces: 49 ft. after 1 hrs. pumping 800 g.p.m. 62 ft. after 2 hrs. pumping 1400 g.p.m. Estimated maximum yield 1400 g.p.m.		
			13. Water sample submitted: Yes <input checked="" type="checkbox"/> No <input type="checkbox"/> Date		
			14. Well head completion: 8 inches above grade <input type="checkbox"/> Pitless adapter		
			15. Well grouted? yes With: <input type="checkbox"/> Neat cement <input type="checkbox"/> Bentonite <input checked="" type="checkbox"/> Concrete Depth: From 0 ft. to 10 ft.		
			16. Nearest source of possible contamination: ft. Direction none Type none Well disinfected upon completion? Yes <input checked="" type="checkbox"/> No <input type="checkbox"/>		
			17. Pump: Not installed Manufacturer's name WESTERN LR Model number 512 SMP 60 Volts Length of drop pipe 80 ft. capacity 800 g.p.m. Type: <input type="checkbox"/> Submersible <input checked="" type="checkbox"/> Turbine <input type="checkbox"/> Jet <input type="checkbox"/> Reciprocating <input type="checkbox"/> Centrifugal <input type="checkbox"/> Other		
18. Elevation:			19. Remarks:		
Topography: <input type="checkbox"/> Hill <input type="checkbox"/> Slope <input checked="" type="checkbox"/> Upland <input type="checkbox"/> Valley			Med. sand & gravel Fine sand & clay		
			20. Water well contractor's certification: This well was drilled under my jurisdiction and this report is true to the best of my knowledge and belief. Rosencrantz-Bemis Ent. Inc. Business name 1211 W. 4th, Hutchinson, KS Address Mike Flowers Signed 6-7-79 Authorized representative Date		