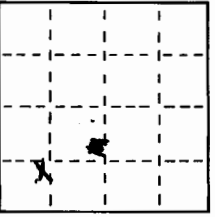
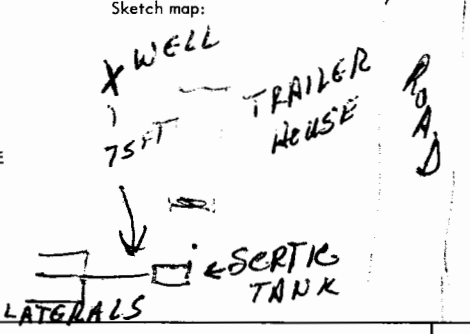


USE TYPEWRITER OR BALL  
POINT PEN—PRESS FIRMLY,  
PRINT CLEARLY.

WATER WELL RECORD  
KSA 82g-1201-1215

2	4		6				NE	S	NE	31
T		R		EW		sec	1/4	1/4	1/4	No.

Kansas State Dept. Of Health  
(Water Well Contractors)  
Forbes-Bldg. 740  
Topeka, Kansas 66620

1 Location of well:	County <b>Reno</b>	Township name <b>Lincoln</b>	Fraction <b>N 1/4 S W 1/4 SW 1/4</b>	Section number <b>31</b>	Town number <b>24</b>	Range number <b>6</b>
Distance and direction from nearest town or city: <b>6 1/2 S Whitesides</b>			3 Owner of well: <b>RICK COFFEE</b> Address: <b>SE HUTCHINSON, KS.</b>			
Street address of well location if in city: <b>on K 61</b>						
Locate with "X" in section below:		Sketch map:		4 Well depth: <b>20</b> ft. Date of completion <b>6-15</b> Well diameter <b>9</b> in. <b>20-90 4 1/2</b>		
				5 <input type="checkbox"/> Cable tool <input checked="" type="checkbox"/> Rotary <input type="checkbox"/> Driven <input type="checkbox"/> Dug <input type="checkbox"/> Hollow rod <input type="checkbox"/> Jetted <input type="checkbox"/> Bored <input type="checkbox"/> Reverse rotary		
2 Type and color of material		From		To		
<b>TOP SOIL</b>		<b>0</b>		<b>4</b>		
<b>DARK BROWN CLAY - TIGHT</b>		<b>4</b>		<b>8</b>		
<b>LIGHT TAN CLAY - SOFT</b>		<b>8</b>		<b>12</b>		
<b>HARD RED SHALE - w STREAKS</b>		<b>12</b>		<b>90</b>		
<b>of softer Blue Clay - streaks</b>						
<b>from 6" to 1 1/2 to 2 feet.</b>						
(use a second sheet if needed)						
16 Remarks: elevation				17 Water well contractor's certification:		
Topography: <input type="checkbox"/> Hill <input type="checkbox"/> Slope <input checked="" type="checkbox"/> Upland <input type="checkbox"/> Valley				This well was drilled under my jurisdiction and this report is true to the best of my knowledge and belief. <b>McLean Dullin G. 227</b> Business name License No. Address <b>KR 3 Hutchinson</b> Signed <b>Sally J. McLean</b> date <b>6-28</b> Authorized representative		