


1 LOCATION OF WATER WELL: County: <u>Reno</u>	Fraction <u>NW</u> $\frac{1}{4}$ <u>NE</u> $\frac{1}{4}$ <u>SW</u> $\frac{1}{4}$	Section Number <u>25</u>	Township Number T <u>24</u> S	Range Number R <u>7</u> E/W <u>(1)</u>
--	---	-----------------------------	----------------------------------	---

Distance and direction from nearest town or city street address of well if located within city?

2 WATER WELL OWNER: RR#, St. Address, Box # : <u>John Evans</u> <u>10919 South Dean Rd.</u> City, State, ZIP Code : <u>Hutchinson, KS 67501</u>	# <u>30</u> Board of Agriculture, Division of Water Resources Application Number: <u>42111</u>
--	--

3 LOCATE WELL'S LOCATION WITH AN "X" IN SECTION BOX:	4 DEPTH OF COMPLETED WELL: <u>70</u> ft. ELEVATION:
--	---

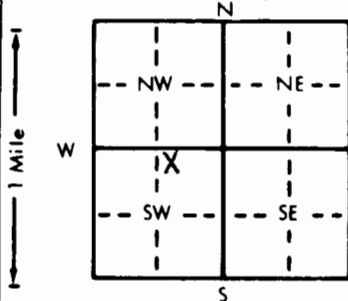

Depth(s) Groundwater Encountered 1 ft. 2. ft. 3. ft.

WELL'S STATIC WATER LEVEL 15 ft. below land surface measured on mo/day/yr 6-21-96

Pump test data: Well water was NA ft. after hours pumping gpm

Est. Yield gpm: Well water was ft. after hours pumping gpm

Bore Hole Diameter: 30 in. to 70 ft. and in. to ft.

WELL WATER TO BE USED AS:

1 Domestic	3 Feedlot	6 Oil field water supply	9 Dewatering	12 Other (Specify below)
2 Irrigation	4 Industrial	7 Lawn and garden only	10 Monitoring well	

Was a chemical/bacteriological sample submitted to Department? Yes No X; If yes, mo/day/yr sample was submitted

Water Well Disinfected? Yes X No

5 TYPE OF BLANK CASING USED:	5 Wrought iron	8 Concrete tile	CASING JOINTS: Glued <u>X</u> Clamped
1 Steel	3 RMP (SR)	6 Asbestos-Cement	9 Other (specify below)
2 PVC	4 ABS	7 Fiberglass	Welded
Blank casing diameter <u>16</u> in. to <u>40</u> ft. Dia			Threaded
Casing height above land surface <u>12</u> in. weight <u>Sch. 40</u> lbs./ft. Wall thickness or gauge No.			
TYPE OF SCREEN OR PERFORATION MATERIAL:	5 Fiberglass	8 RMP (SR)	10 Asbestos-cement
1 Steel	3 Stainless steel	6 Concrete tile	9 ABS
2 Brass	4 Galvanized steel		11 Other (specify)
SCREEN OR PERFORATION OPENINGS ARE:	5 Gauzed wrapped	8 Saw cut	11 None (open hole)
1 Continuous slot	3 Mill slot	9 Drilled holes	
2 Louvered shutter	4 Key punched	10 Other (specify)	
SCREEN-PERFORATED INTERVALS:	From <u>40</u> ft. to <u>70</u> ft.		
	From <u>20</u> ft. to <u>70</u> ft.		
GRAVEL PACK INTERVALS:	From <u>20</u> ft. to <u>70</u> ft.		
	From <u>20</u> ft. to <u>70</u> ft.		

6 GROUT MATERIAL:	1 Neat cement	2 Cement grout	3 Bentonite	4 Other
Grout Intervals: From <u>0</u> ft. to <u>20</u> ft.				
What is the nearest source of possible contamination:				
1 Septic tank	4 Lateral lines	7 Pit privy	10 Livestock pens	14 Abandoned water well
2 Sewer lines	5 Cess pool	8 Sewage lagoon	11 Fuel storage	15 Oil well/Gas well
3 Watertight sewer lines	6 Seepage pit	9 Feedyard	12 Fertilizer storage	16 Other (specify below)
			13 Insecticide storage	<u>NA</u>

Direction from well?	How many feet?
FROM TO LITHOLOGIC LOG	FROM TO PLUGGING INTERVALS
0 3 Top Soil	
3 22 Brown Clay	
22 70 Medium Sand	
70 Shale	

7 CONTRACTOR'S OR LANDOWNER'S CERTIFICATION: This water well was (1) constructed (2) reconstructed, or (3) plugged under my jurisdiction and was completed on (mo/day/year) <u>6-21-96</u> and this record is true to the best of my knowledge and belief. Kansas Water Well Contractor's License No. <u>537</u> This Water Well Record was completed on (mo/day/yr) <u>6-30-96</u> under the business name of <u>Flowers Drilling &amp; Pump Service</u> by (signature) <u>Niki Flowers</u>
--