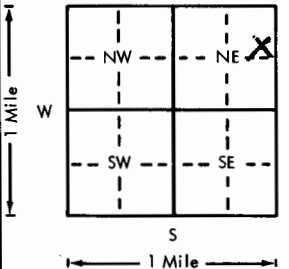
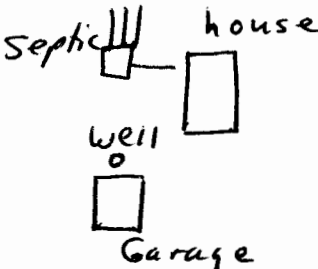


USE TYPEWRITER OR BALL  
POINT PEN-PRESS FIRMLY,  
PRINT CLEARLY.

WATER WELL RECORD  
KSA 82a-1201-1215

Kansas Department of Health and  
Environment-Division of Environment  
(Water well Contractors)  
Topeka, Kansas 66620

1. Location of well: County <u>Reno</u> Fraction <u>SE 1/4 NE 1/4 NE 1/4</u> Section number <u>3</u> Township number <u>T 24</u> Range number <u>S 7 R 7</u> <u>EW</u>	2. Distance and direction from nearest town or city: <u>2 N 1 E Partridge Kan.</u> Street address of well location if in city:	3. Owner of well: <u>Edward E. Miller</u> R.R. or street: <u>RFD</u> City, state, zip code: <u>Partridge Kan. 67566</u>
4. Locate with "X" in section below:  Sketch map: 	6. Bore hole dia. <u>12</u> in. Completion date <u>4-29-77</u> Well depth <u>64</u> ft.	7. Cable tool <input checked="" type="checkbox"/> Rotary <input type="checkbox"/> Driven <input type="checkbox"/> Dug <input type="checkbox"/> Hollow rod <input type="checkbox"/> Jetted <input type="checkbox"/> Bored <input type="checkbox"/> Reverse rotary
5. Type and color of material	8. Use: <input checked="" type="checkbox"/> Domestic <input type="checkbox"/> Public supply <input type="checkbox"/> Industry <input checked="" type="checkbox"/> Irrigation <input type="checkbox"/> Air conditioning <input type="checkbox"/> Stock <input checked="" type="checkbox"/> Lawn <input type="checkbox"/> Oil field water <input type="checkbox"/> Other	9. Casing: Material <u>Plas</u> Height: <u>Above</u> or below Threaded <input type="checkbox"/> Welded <u>64</u> Surface <u>12</u> in. RMP <input checked="" type="checkbox"/> PVC <input type="checkbox"/> Weight <input type="checkbox"/> lbs./ft. Dia. <u>6</u> in. to <u>64</u> ft. depth Wall Thickness: inches or Dia. <input type="checkbox"/> in. to <input type="checkbox"/> ft. depth gage No. <u>1175</u>
	10. Screen: Manufacturer's name <u>J&amp;L</u> Type <u>RMP</u> Dia. <u>6"</u> Slot/gauze <u>1/8 hole</u> Length <u>20'</u> Set between <u>44</u> ft. and <u>64</u> ft. Gravel pack? <u>yes</u> Size range of material <u>1/8-1/2"</u>	11. Static water level: <u>34</u> ft. below land surface Date <u>4-29-77</u>
	12. Pumping level below land surfaces: <u>37</u> ft. after <u>2</u> hrs. pumping <u>15</u> g.p.m. <u>   </u> ft. after <u>   </u> hrs. pumping <u>   </u> g.p.m. Estimated maximum yield <u>20</u> g.p.m.	13. Water sample submitted: <u>   </u> mo./day/yr. <u>   </u> Yes <input checked="" type="checkbox"/> No <input type="checkbox"/> Date <u>   </u>
	14. Well head completion: <u>   </u> Pitless adapter <u>12</u> Inches above grade	15. Well grouted? <u>yes</u> With: <input checked="" type="checkbox"/> Neat cement <input type="checkbox"/> Bentonite <input type="checkbox"/> Concrete Depth: From <u>3</u> ft. to <u>13</u> ft.
	16. Nearest source of possible contamination: ft. <u>60</u> Direction <u>N</u> Type <u>Septic</u> Well disinfected upon completion? <input checked="" type="checkbox"/> Yes <input type="checkbox"/> No	17. Pump: <input checked="" type="checkbox"/> Not installed Manufacturer's name <u>   </u> Model number <u>   </u> HP <u>   </u> Volts <u>   </u> Length of drop pipe <u>   </u> ft. capacity <u>   </u> g.p.m. Type: <input type="checkbox"/> Submersible <input type="checkbox"/> Turbine <input type="checkbox"/> Jet <input type="checkbox"/> Reciprocating <input type="checkbox"/> Centrifugal <input type="checkbox"/> Other
18. Elevation:	19. Remarks:	20. Water well contractor's certification: This well was drilled under my jurisdiction and this report is true to the best of my knowledge and belief. <u>Price Water Well 193</u> Business name <u>RR3 Hutchinson</u> License No. <u>   </u> Address <u>   </u> Signed <u>John Davenport</u> Date <u>5-20-77</u> Authorized representative