

| | | | | |
|---------------------------|---|----------------|-----------------|-----------------------|
| 1 LOCATION OF WATER WELL: | Fraction | Section Number | Township Number | Range Number |
| County: <u>Reno</u> | <u>SW</u> 1/4 <u>SE</u> 1/4 <u>SW</u> 1/4 | <u>6</u> | T <u>24</u> S | R <u>7</u> E <u>W</u> |


Distance and direction from nearest town or city street address of well if located within city?
1 mi N, 2 1/2 W of Partridge

2 WATER WELL OWNER: Dennis Schmidt
RR#, St. Address, Box # : Rt 1, Box 100
City, State, ZIP Code : Arlington, KS 67514

Board of Agriculture, Division of Water Resources
Application Number:

3 LOCATE WELL'S LOCATION WITH AN "X" IN SECTION BOX: 4 DEPTH OF COMPLETED WELL: 43 ft. ELEVATION:

Depth(s) Groundwater Encountered 1. ft. 2. ft. 3. ft.

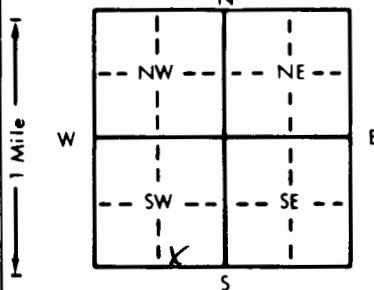

4 DEPTH OF COMPLETED WELL. 43 ft. ELEVATION: _____

Depth(s) Groundwater Encountered 1. _____ ft. 2. _____ ft. 3. _____ ft.

WELL'S STATIC WATER LEVEL 1.7 ft. below land surface measured on mo/day/yr 2-1-92

Pump test data: Well water was 2.4 ft. after 1 1/2 hours pumping 30 gpm

Est. Yield _____ gpm: Well water was _____ ft. after _____ hours pumping _____ gpm

Bore Hole Diameter 8 in. to _____ ft., and _____ in. to _____ ft.

WELL WATER TO BE USED AS:

| | | | | |
|---------------------------------------|---------------------------------------|---|---|---|
| <input type="checkbox"/> Domestic | <input type="checkbox"/> 3 Feedlot | <input type="checkbox"/> 6 Oil field water supply | <input type="checkbox"/> 9 Dewatering | <input type="checkbox"/> 11 Injection well |
| <input type="checkbox"/> 2 Irrigation | <input type="checkbox"/> 4 Industrial | <input type="checkbox"/> 7 Lawn and garden only | <input type="checkbox"/> 10 Monitoring well | <input type="checkbox"/> 12 Other (Specify below) |

Was a chemical/bacteriological sample submitted to Department? Yes _____ No X _____; If yes, mo/day/yr sample was submitted _____

Water Well Disinfected? Yes X No _____

| | | | | | | |
|----------------------------------|----------------------------|-------------|-------------------|-------------------------|---|--|
| 5 | TYPE OF BLANK CASING USED: | | 5 Wrought iron | 8 Concrete tile | CASING JOINTS: Glued <input checked="" type="checkbox"/> Clamped <input type="checkbox"/> | |
| | 1 Steel | 3 RMP (SR) | 6 Asbestos-Cement | 9 Other (specify below) | Welded <input type="checkbox"/> | |
| | ② PVC | 4 ABS | 7 Fiberglass | | Threaded <input type="checkbox"/> | |
| | | | | | | |
| Blank casing diameter | | 5 in. to 37 | ft. Dia | | in. to ft. | |
| Casing height above land surface | | 24 in. | weight lbs./ft. | | Wall thickness or gauge No. 160 | |

| TYPE OF SCREEN OR PERFORATION MATERIAL: | | | | | |
|---|--------------------|-----------------|------------|--------------------------|--|
| 1 Steel | 3 Stainless steel | 5 Fiberglass | 7 PVC | 10 Asbestos-cement | |
| 2 Brass | 4 Galvanized steel | 6 Concrete tile | 8 RMP (SR) | 11 Other (specify) | |
| | | | 9 ABS | 12 None used (open hole) | |

SCREEN OR PERFORATION OPENINGS ARE:

| | | | | |
|--------------------|---------------|------------------|--------------------------|---------------------|
| 1 Continuous slot | 3 Mill slot | 5 Gauzed wrapped | 8 Saw cut | 11 None (open hole) |
| 2 Louvered shutter | 4 Key punched | 6 Wire wrapped | 9 Drilled holes | |
| | | 7 Torch cut | 10 Other (specify) | |

SCREEN PERFORATED INTERVALS: From 37 ft. to 43 ft.

| | | | | | |
|------------------------------|------|--------|----------|--------|-----|
| SCREEN-PERFORATED INTERVALS: | From | ft. to | ft. From | ft. to | ft. |
| | From | ft. to | ft. From | ft. to | ft. |
| GRAVEL PACK INTERVALS: | From | ft. to | ft. From | ft. to | ft. |
| | From | ft. to | ft. From | ft. to | ft. |

6 GROUT MATERIAL: 1 Neat cement 2 Cement grout 3 Bentonite 4 Other

Grout Intervals: From 3 ft. to 23 ft. From ft. to ft. From ft. to ft.

What is the nearest source of possible contamination:

1 Septic tank 4 Lateral lines 7 Pit privy 10 Livestock pens 14 Abandoned water well

2 Sewer lines 5 Cess pool 8 Sewage lagoon 11 Fuel storage 15 Oil well/Gas well

3 Watertight sewer lines 6 Seepage pit 9 Feedyard 12 Fertilizer storage 16 Other (specify below)

13 Insecticide storage

Direction from well? E How many feet? 500

[illegible]

7 CONTRACTOR'S OR LANDOWNER'S CERTIFICATION: This water well was (1) constructed, (2) reconstructed, or (3) plugged under my jurisdiction and was completed on (mo/day/year) 2-1-92 and this record is true to the best of my knowledge and belief. Kansas Water Well Contractor's License No. 447 This Water Well Record was completed on (mo/day/yr) 2-11-92 under the business name of Miller Drilling by (signature) G. Mills