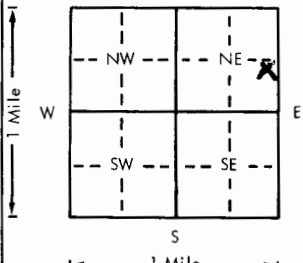



USE TYPEWRITER OR BALL
POINT PEN-PRESS FIRMLY,
PRINT CLEARLY.

WATER WELL RECORD
KSA 82a-1201-1215

Kansas Department of Health and
Environment-Division of Environment
(Water well Contractors)
Topeka, Kansas 66620

1. Location of well:		County Reno	Fraction NE 1/4 SE 1/4 NE 1/4	Section number 14	Township number T 24 S	Range number R 7 W
2. Distance and direction from nearest town or city: 2 Mi E, 1/3 S		3. Owner of well: Paul Miller R.R. or street: RR 1 City, state, zip code: Partridge, KS 67566				
4. Locate with "X" in section below:		Sketch map:				
						
5. Type and color of material		From	To	6. Bore hole dia. 9 in. Completion date 9-20-77 Well depth 55 ft.		
Sandy silt		0	6	7. <input checked="" type="checkbox"/> Cable tool <input checked="" type="checkbox"/> Rotary <input type="checkbox"/> Driven <input type="checkbox"/> Dug <input type="checkbox"/> Hollow rod <input type="checkbox"/> Jetted <input type="checkbox"/> Bored <input type="checkbox"/> Reverse rotary		
Brown clay		6	14	8. Use: <input checked="" type="checkbox"/> Domestic <input type="checkbox"/> Public supply <input type="checkbox"/> Industry <input type="checkbox"/> Irrigation <input type="checkbox"/> Air conditioning <input type="checkbox"/> Stock <input type="checkbox"/> Lawn <input type="checkbox"/> Oil field water <input type="checkbox"/> Other		
Sand & gravel		14	57	9. Casing: Material PVC Height: <input checked="" type="checkbox"/> Above <input type="checkbox"/> below Threaded <input type="checkbox"/> Welded <input type="checkbox"/> Surface 13 in. RMP <input checked="" type="checkbox"/> PVC <input type="checkbox"/> Weight <input type="checkbox"/> lbs./ft. Dia. 5 in. to 55 ft. depth Wall Thickness: inches or Dia. <input type="checkbox"/> in. to <input type="checkbox"/> ft. depth gage No. 200		
				10. Screen: Manufacturer's name J+L Type RMP Dia. 5" Slot/duze 060 Length 10' Set between 45 ft. and 55 ft. ft. and ft. Gravel pack? <input checked="" type="checkbox"/> Size range of material F-1/2		
				11. Static water level: <input type="checkbox"/> mo./day/yr. 33 ft. below land surface Date 9-20-77		
				12. Pumping level below land surfaces: 34 ft. after 2 hrs. pumping 25 g.p.m. ft. after hrs. pumping g.p.m. Estimated maximum yield 40 g.p.m.		
				13. Water sample submitted: <input type="checkbox"/> mo./day/yr. Yes <input checked="" type="checkbox"/> No Date		
				14. Well head completion: Pitless adapter 13 Inches above grade		
				15. Well grouted? Yes With: <input checked="" type="checkbox"/> Neat cement <input type="checkbox"/> Bentonite <input type="checkbox"/> Concrete Depth: From 3 ft. to 13 ft.		
				16. Nearest source of possible contamination: ft. 50 Direction NW Type Septic Well disinfected upon completion? <input checked="" type="checkbox"/> Yes <input type="checkbox"/> No		
				17. Pump: <input checked="" type="checkbox"/> Not installed Manufacturer's name Model number HP Volts Length of drop pipe ft. capacity g.p.m. Type: <input type="checkbox"/> Submersible <input type="checkbox"/> Turbine <input type="checkbox"/> Jet <input type="checkbox"/> Reciprocating <input type="checkbox"/> Centrifugal <input type="checkbox"/> Other		
		(Use a second sheet if needed)				
18. Elevation:	19. Remarks:		20. Water well contractor's certification: This well was drilled under my jurisdiction and this report is true to the best of my knowledge and belief. Miller Water Well (37) Business name License No. Address Hutchinson, KS Signed Joe Miller 6-15-78 Date Authorized representative			
Topography: <input type="checkbox"/> Hill <input type="checkbox"/> Slope <input checked="" type="checkbox"/> Upland <input type="checkbox"/> Valley						