


|  |   |                             |                                  |                                       |
|--|---|-----------------------------|----------------------------------|---------------------------------------|
| 1 LOCATION OF WATER WELL:<br>County: <u>Reno</u> | Fraction<br><u>SE 1/4 NE 1/4 SE 1/4</u> | Section Number<br><u>23</u> | Township Number<br>T <u>24</u> S | Range Number<br>R <u>7</u> E <u>W</u> |
|--|---|-----------------------------|----------------------------------|---------------------------------------|

Distance and direction from nearest town or city street address of well if located within city?

1 mi E, 1 1/2 S of Partridge

|   |   |  |
|---|---|--|
| 2 WATER WELL OWNER:<br>RR#, St. Address, Box # :<br>City, State, ZIP Code : | <u>Todd Murrey</u><br><u>Rt 1</u><br><u>Partridge, KS 67566</u> | Board of Agriculture, Division of Water Resources<br>Application Number: |
|---|---|--|

|  |   |
|--|---|
| 3 LOCATE WELL'S LOCATION WITH AN "X" IN SECTION BOX: | 4 DEPTH OF COMPLETED WELL: <u>80</u> ft. ELEVATION: |
|--|---|

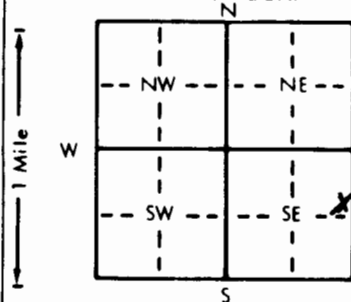

Depth(s) Groundwater Encountered 1. .... ft. 2. .... ft. 3. .... ft.

WELL'S STATIC WATER LEVEL 18 ft. below land surface measured on mo/day/yr 6-20-90Pump test data: Well water was 21 ft. after 1 hours pumping 30 gpm

Est. Yield .... gpm: Well water was .... ft. after .... hours pumping .... gpm

Bore Hole Diameter 8 in. to 8.3 ft., and .... in. to .... ft.

WELL WATER TO BE USED AS: 5 Public water supply 8 Air conditioning 11 Injection well

☒ Domestic 3 Feedlot 6 Oil field water supply 9 Dewatering 12 Other (Specify below)

2 Irrigation 4 Industrial 7 Lawn and garden only 10 Monitoring well

Was a chemical/bacteriological sample submitted to Department? Yes.....No.....X..... If yes, mo/day/yr sample was sub-mitted Water Well Disinfected? Yes X No

|                              |                |                 |                                       |
|------------------------------|----------------|-----------------|---------------------------------------|
| 5 TYPE OF BLANK CASING USED: | 5 Wrought iron | 8 Concrete tile | CASING JOINTS: Glued <u>X</u> Clamped |
|------------------------------|----------------|-----------------|---------------------------------------|

1 Steel 3 RMP (SR) 6 Asbestos-Cement 9 Other (specify below) Welded

☒ PVC 4 ABS 7 Fiberglass ThreadedBlank casing diameter 5 in. to 7.1 ft., Dia. .... in. to .... ft., Dia. .... in. to .... ft.Casing height above land surface 12 in., weight .... lbs./ft. Wall thickness or gauge No. 160TYPE OF SCREEN OR PERFORATION MATERIAL: ☒ PVC 10 Asbestos-cement

1 Steel 3 Stainless steel 5 Fiberglass 8 RMP (SR) 11 Other (specify)

2 Brass 4 Galvanized steel 6 Concrete tile 9 ABS 12 None used (open hole)

SCREEN OR PERFORATION OPENINGS ARE: 5 Gauzed wrapped ☒ Saw cut 11 None (open hole)

1 Continuous slot 3 Mill slot 6 Wire wrapped 9 Drilled holes

2 Louvered shutter 4 Key punched 7 Torch cut 10 Other (specify)

SCREEN-PERFORATED INTERVALS: From 7.1 ft. to 80 ft., From .... ft. to .... ft.

From .... ft. to .... ft., From .... ft. to .... ft.

GRAVEL PACK INTERVALS: From 19 ft. to 83 ft., From .... ft. to .... ft.

From .... ft. to .... ft., From .... ft. to .... ft.

|                   |               |                |  |         |
|-------------------|---------------|----------------|--|---------|
| 6 GROUT MATERIAL: | 1 Neat cement | 2 Cement grout | <input checked="" type="radio"/> Bentonite | 4 Other |
|-------------------|---------------|----------------|--|---------|

Grout Intervals: From 3 ft. to 19 ft., From .... ft. to .... ft., From .... ft. to .... ft.

What is the nearest source of possible contamination: 10 Livestock pens 14 Abandoned water well

☒ Septic tank 4 Lateral lines 7 Pit privy 11 Fuel storage 15 Oil well/Gas well

2 Sewer lines 5 Cess pool 8 Sewage lagoon 12 Fertilizer storage 16 Other (specify below)

3 Watertight sewer lines 6 Seepage pit 9 Feedyard 13 Insecticide storage

Direction from well? NW How many feet? 110

FROM TO LITHOLOGIC LOG FROM TO PLUGGING INTERVALS

|    |    |                  |
|----|----|------------------|
| 0  | 14 | Br clay          |
| 14 | 50 | Sand + Sm Gravel |
| 50 | 83 | Sand + Gravel    |

|   |
|---|
| 7 CONTRACTOR'S OR LANDOWNER'S CERTIFICATION: This water well was <input checked="" type="radio"/> constructed, (2) reconstructed, or (3) plugged under my jurisdiction and was completed on (mo/day/year) <u>6-20-90</u> and this record is true to the best of my knowledge and belief. Kansas |
|---|

Water Well Contractor's License No. 447 This Water Well Record was completed on (mo/day/yr) 7-8-90under the business name of Miller Drilling by (signature) E. Miller