

# WATER WELL PLUGGING RECORD Form WWC-5P

KSA 82a-1212

ID NO.

20110363

1 LOCATION OF WATER WELL: Fraction SW 1/4 NE 1/4 SE 1/4 SE 1/4 Section Number 24 Township Number T 24 S Range Number 9 ☐ E ☒ W  
County: Reno

Street/Rural Address of Well Location; if unknown, distance & direction from nearest town or intersection: If at owner's address, check here ☐ From Plevna: 3 W 1 1/2 S WSR

## Global Positioning Systems (GPS) information:

Latitude: 37.94374 (in decimal degrees)  
Longitude: 098.25381 (in decimal degrees)

Elevation: 1638

Datum: ☐ WGS84, ☐ NAD83, ☒ NAD27

## Collection Method:


☒ GPS unit (Make/Model: Garmin csx

☐ Digital Map/Photo, ☒ Topographic Map, ☐ Land Survey

Est. Accuracy: ☐ < 3 m, ☒ 3-5 m, ☐ 5-15 m, ☐ > 15 m

2 WATER WELL OWNER: WEST CON  
RR#, St. Address, Box #: 10011-B Woodend Road  
City, State ZIP Code: Edwardsville, Ks. 66111

## 3 MARK WELL'S LOCATION WITH AN "X" IN SECTION BOX:

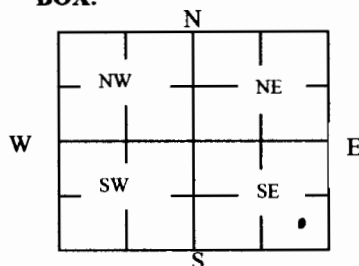

## 4 DEPTH OF WELL 24 ft.

WELL'S STATIC WATER LEVEL 4 ft

## WELL WAS USED AS:

☐ Domestic  
☐ Irrigation  
☐ Feedlot  
☐ Industrial

☐ Public Water Supply  
☐ Oil Field Water Supply  
☐ Domestic (Lawn & Garden)  
☐ Air Conditioning

☒ Dewatering  
☐ Monitoring  
☐ Injection Well  
☐ Other

Was a chemical/bacteriological sample submitted to Department? Yes ☐ No ☒

## 5 TYPE OF BLANK CASING USED:

☐ Steel  
☒ PVC

☐ RMP (SR)  
☐ ABS

☐ Wrought  
☐ Asbestos-Cement

☐ Fiberglass  
☐ Concrete Tile

☐ Other (Specify below)

Blank casing diameter 8 in. Was casing pulled? Yes ☒ No ☐ If yes, how much 24'

Casing height above or below land surface n/a in.

## 6 GROUT PLUG MATERIAL: ☐ Neat cement ☐ Cement grout ☒ Bentonite ☒ Other c. gravel - t.soil

Grout Plug Intervals: From 24 ft. to 4 ft., From 4 ft. to 3 ft., From 3 to 0 ft.

## What is the nearest source of possible contamination:

☐ Septic tank  
☐ Sewer lines  
☐ Watertight sewer lines  
☐ Lateral lines  
☐ Cess pool

☐ Seepage pit  
☐ Pit privy  
☐ Sewage lagoon  
☐ Feedyard  
☐ Livestock pens

☐ Fuel Storage  
☐ Fertilizer storage  
☐ Insecticide storage  
☐ Abandoned water well  
☐ Oil well/Gas well

☒ Other (specify below)  
none

Direction from well? n/a

How many feet? n/a

FROM	TO	PLUGGING MATERIALS	FROM	TO	PLUGGING MATERIALS
0	3	Top soil			
3	4	Benonite			
4	24	Chlorinated gravel			

7 CONTRACTOR'S OR LANDOWNER'S CERTIFICATION: This water well was plugged under my jurisdiction and was completed on (mo/day/year) 9-26-2011 and this record is true to the best of my knowledge and belief. Kansas Water Well Contractor's License No. 134 This Water Well Record was completed on (mo/day/year) 9-28-2011 under the business name of Rosencrantz-Bemis Ent. by (signature) *Jessie D. Davis*

INSTRUCTIONS: Use typewriter or ballpoint pen. Please press firmly and print clearly. Please fill in blanks, underline or circle the correct answers. Send top three copies to Kansas Department of Health and Environment, Bureau of Water, Geology Section, 1000 SW Jackson St., Ste. 420, Topeka, Kansas 66612-1367. Telephone: 785/296-5524. Send one to Water Well Owner and retain one for your records. Visit us at <http://www.kdheks.gov/waterwell/index.html>.

Check one: ☒ White Copy ☐ Blue Copy ☐ Pink Copy