WATER WELL RECORD Form WWC-5 KSA 82a-1212

1 LOCATION OF WATER WELL:	Fraction	Section Number	Township Number	Range Number
County: Sedgwick	SW ¼ NW ¼ SE ¼	36	T 25 S	R 1 E/W

Distance and direction from nearest town or city street address of well if located within city?
1000' SW of Valley Center, Ks WELL #3/18

2 WATER WELL OWNER: Barton Solvents
RR#, St. Address, Box # : 201 S. Cedar
City, State, ZIP Code : Valley Center, Ks, 67147

Board of Agriculture, Division of Water Resources
Application Number:

3 LOCATE WELL'S LOCATION WITH AN "X" IN SECTION BOX:

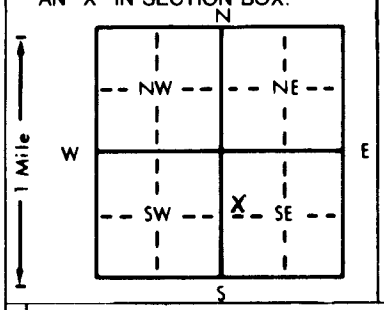

4 DEPTH OF COMPLETED WELL 32.5 ft. ELEVATION: 1347
Depth(s) Groundwater Encountered 1. NA ft. 2. NA ft. 3. NA ft.
WELL'S STATIC WATER LEVEL 20 ft. below land surface measured on mo/day/yr 9/19/99
Pump test data: Well water was NA ft. after NA hours pumping NA gpm
Est. Yield 2 gpm: Well water was NA ft. after NA hours pumping NA gpm
Bore Hole Diameter 8 in. to 32.5 ft., and NA in. to NA ft.
WELL WATER TO BE USED AS: 5 Public water supply 8 Air conditioning 11 Injection well
1 Domestic 3 Feedlot 6 Oil field water supply 9 Dewatering 12 Other (Specify below)
2 Irrigation 4 Industrial 7 Lawn and garden only 10 Monitoring well Sparge Point
Was a chemical/bacteriological sample submitted to Department? Yes ..... No X ; If yes, mo/day/yr sample was submitted
Water Well Disinfected? Yes No X

5 TYPE OF BLANK CASING USED: 5 Wrought iron 8 Concrete tile CASING JOINTS: Glued Clamped
1 Steel 3 RMP (SR) 6 Asbestos-Cement 9 Other (specify below) Welded
2 PVC 4 ABS 7 Fiberglass Threaded Flush
Blank casing diameter 2.375 in. to 30.0 ft., Dia NA in. to NA ft., Dia NA in. to NA ft.
Casing height above land surface 0 in., weight 0.687 lbs./ft. Wall thickness or gauge No. Sch 40 (0.154)
TYPE OF SCREEN OR PERFORATION MATERIAL: 1 PVC 10 Asbestos-cement
1 Steel 3 Stainless steel 5 Fiberglass 8 RMP (SR) 11 Other (specify)
2 Brass 4 Galvanized steel 6 Concrete tile 9 ABS 12 None used (open hole)
SCREEN OR PERFORATION OPENINGS ARE: 5 Gauzed wrapped 8 Saw cut 11 None (open hole)
1 Continuous slot 3 Mill slot 6 Wire wrapped 9 Drilled holes
2 Louvered shutter 4 Key punched 7 Torch cut 10 Other (specify)
SCREEN-PERFORATED INTERVALS: From 30.0 ft. to 32.5 ft., From NA ft. to NA ft.
From NA ft. to NA ft., From NA ft. to NA ft.
GRAVEL PACK INTERVALS: From 29.5 ft. to 32.5 ft., From NA ft. to NA ft.
From NA ft. to NA ft., From NA ft. to NA ft.

6 GROUT MATERIAL: 1 Neat cement 2 Cement grout 3 Bentonite 4 Other Bentonite 29'-29.5'
Grout Intervals: From 0 ft. to 29 ft., From ft. to ft., From ft. to ft.
What is the nearest source of possible contamination: 10 Livestock pens 14 Abandoned water well
1 Septic tank 4 Lateral lines 7 Pit privy 11 Fuel storage 15 Oil well/Gas well
2 Sewer lines 5 Cess pool 8 Sewage lagoon 12 Fertilizer storage 16 Other (specify below)
3 Watertight sewer lines 6 Seepage pit 9 Feedyard 13 Insecticide storage
Direction from well? How many feet?

FROM	TO	LITHOLOGIC LOG	FROM	TO	PLUGGING INTERVALS
0	1'	soil			
1'	14'	clay, brown			
14'	32.5'	sd, vr fn to fn grn			

7 CONTRACTOR'S OR LANDOWNER'S CERTIFICATION: This water well was (1) constructed, (2) reconstructed, or (3) plugged under my jurisdiction and was completed on (mo/day/year) 9/19/99 and this record is true to the best of my knowledge and belief. Kansas Water Well Contractor's License No. 581 This Water Well Record was completed on (mo/day/yr) 10/28/99 under the business name of Layne Western by (signature) Ken Walsh

INSTRUCTIONS: Use typewriter or ball point pen. *PLEASE PRESS FIRMLY* and *PRINT* clearly. Please fill in blanks, underline or circle the correct answers. Send top three copies to Kansas Department of Health and Environment, Bureau of Water, Topeka, Kansas 66620-0001. Telephone: 913-296-5545. Send one to WATER WELL OWNER and retain one for your records.

OFFICE USE ONLY T R E/W SEC. ¼ ¼ ¼