①

WATER WELL RECORD Form WWC-5 KSA 82a-1212 ID No. _____

1 LOCATION OF WATER WELL:	Fraction	Section Number	Township Number	Range Number
County: Sedgwick	SE ¼ NE ¼ SE ¼	36	T 25 S	R 1 E (W)

Distance and direction from nearest town or city street address of well if located within city?

2 WATER WELL OWNER: USD #262 Bus Garage
RR#, St. Address, Box # : 2155 S. Park
City, State, ZIP Code : Valley Center, Ks.

Board of Agriculture, Division of Water Resources
Application Number:

3 LOCATE WELL'S LOCATION WITH AN "X" IN SECTION BOX:

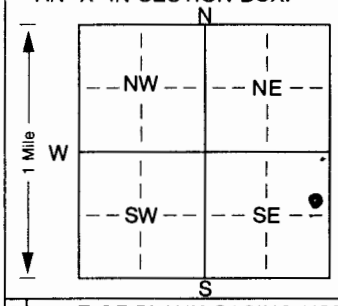

4 DEPTH OF COMPLETED WELL: 20' ft. ELEVATION:
Depth(s) Groundwater Encountered 1. 14' ft. 2. ft. 3. ft.
WELL'S STATIC WATER LEVEL 15.06 ft. below land surface measured on mo/day/yr 11-15-00
Pump test data: Well water was ft. after hours pumping gpm
Est. Yield — gpm: Well water was ft. after hours pumping gpm
Bore Hole Diameter 8½" in. to 20' ft., and in. to ft.
WELL WATER TO BE USED AS: 5 Public water supply 8 Air conditioning 11 Injection well
1 Domestic 3 Feedlot 6 Oil field water supply 9 Dewatering 12 Other (Specify below)
2 Irrigation 4 Industrial 7 Domestic (lawn & garden) (10) Monitoring well
Was a chemical/bacteriological sample submitted to Department? Yes No X ; If yes, mo/day/yrs sample was submitted
Water Well Disinfected? Yes (No)

5 TYPE OF BLANK CASING USED: 5 Wrought iron 8 Concrete tile CASING JOINTS: Glued Clamped
1 Steel 3 RMP (SR) 6 Asbestos-Cement 9 Other (specify below) Welded
[2 PVC] 4 ABS 7 Fiberglass Threaded X
Blank casing diameter 2.375 in. to 10' ft., Dia in. to ft., Dia in. to ft.
Casing height above land surface Flush Mt. in., weight lbs./ft. Wall thickness or gauge No. SDR-13
TYPE OF SCREEN OR PERFORATION MATERIAL: [7 PVC] 10 Asbestos-cement Sch 40
1 Steel 3 Stainless steel 5 Fiberglass 8 RMP (SR) 11 Other (specify)
2 Brass 4 Galvanized steel 6 Concrete tile 9 ABS 12 None used (open hole)
SCREEN OR PERFORATION OPENINGS ARE: 5 Gauzed wrapped 8 Saw cut 11 None (open hole)
1 Continuous slot [3 Mill slot] 6 Wire wrapped 9 Drilled holes
2 Louvered shutter 4 Key punched 7 Torch cut 10 Other (specify) ft.
SCREEN-PERFORATED INTERVALS: From 20' ft. to 10' ft., From ft. to ft.
From ft. to ft., From ft. to ft.
GRAVEL PACK INTERVALS: From 20' ft. to 8' ft., From ft. to ft.
From ft. to ft., From ft. to ft.

6 GROUT MATERIAL: 1 Neat cement (2) Cement grout (3) Bentonite 4 Other
Grout Intervals: From 8' ft. to 3' ft., From 3' ft. to 0' ft., From ft. to ft.
(3) (2)
What is the nearest source of possible contamination: 10 Livestock pens 14 Abandoned water well
1 Septic tank 4 Lateral lines 7 Pit privy (11) Fuel storage 15 Oil well/Gas well
2 Sewer lines 5 Cess pool 8 Sewage lagoon 12 Fertilizer storage 16 Other (specify below)
3 Watertight sewer lines 6 Seepage pit 9 Feedyard 13 Insecticide storage
Direction from well? In old Pit How many feet?

FROM	TO	LITHOLOGIC LOG	FROM	TO	PLUGGING INTERVALS
0	1.2	Ls. Rx Garage			
1.2	6.5	Brn sand fill (sand) fine-coarse dry no odor			
6.5	13.20	Brn clayey sand, fill, moist, no odor			
		Tan-Brn fine-coarse sand, wet no odor			
					F.H. OK'd by D. Taylor

7 CONTRACTOR'S OR LANDOWNER'S CERTIFICATION: This water well was (1) [constructed,] (2) reconstructed, or (3) plugged under my jurisdiction and was completed on (mo/day/year) 11-14-00 and this record is true to the best of my knowledge and belief. Kansas Water Well Contractor's Licence No. 539 This Water Well Record was completed on (mo/day/yr) 11-16-00
under the business name of JB Env. Drilling by (signature) James Bieker

INSTRUCTIONS: Use typewriter or ball point pen. *PLEASE PRESS FIRMLY* and *PRINT* clearly. Please fill in blanks, underline or circle the correct answers. Send top three copies to Kansas Department of Health and Environment, Bureau of Water, Topeka, Kansas 66620-0001. Telephone 785-296-5524. Send one to WATER WELL OWNER and retain one for your records. Fee of $5.00 for each constructed well.