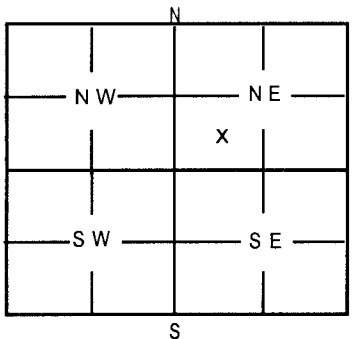


1	LOCATION OF WATER WELL:	Fraction	Section	Number	Township	Number	Range	Number
	County: Sedgwick	NC 1/4 SW 1/4 NE 1/4	36		T	25	S	R 1 E

Distance and direction from nearest town or city street address of well if located within city?

At 555 W. 2nd, Valley Center


2	WATER WELL OWNER:	City of Valley Center
	RR#, St. Address, Box #	P.O. Box 188
	City, State, ZIP Code	Valley Center, KS 67147
		Board of Agriculture, Division of Water Resources
		Application Number:

3	MARK WELL'S LOCATION WITH AN "X" IN SECTION BOX:	4	DEPTH OF WELL	51	ft
			WELL'S STATIC WATER LEVEL	17	ft.
			WELL WAS USED AS:		
			1 Domestic	5 Public Water Supply	9 Dewatering
			2 Irrigation	6 Oil Field Water Supply	10 Monitoring Well
			3 Feedlot	7 Domestic (Lawn & Garden)	11 Injection Well
			4 Industrial	8 Air Conditioning	12 Other
			Was a chemical / bacteriological sample submitted to Department? Yes No ☒		
			If yes, mo/day/yr sample was submitted		
			Water Well Disinfected: Yes ☒ No		

5	TYPE OF BLANK CASING USED:	
	1 Steel	3 RMP (SR)
	2 PVC	4 ABS
	5 Wrought	6 Asbestos-Cement
	7 Fiberglass	8 Concrete Tile
	9 Other (Specify below)	Cement
	Blank casing diameter	18 in.
	Was casing pulled?	Yes No ☒
	Casing height above or below land surface	48 in.
		If yes, how much Cut off

6	GROUT PLUG MATERIAL:	1 Neat Cement	2 Cement grout	3 Bentonite	4 Other
	Grout Plug Intervals:	From 20 ft. to 4 ft.	From ft. to ft.	From ft. to ft.	From ft. to ft.
	What is the nearest source of possible contamination:				
	1 Septic tank	6 Seepage pit	11 Fuel storage	16 Other (specify below)	
	2 Sewer lines	7 Pit privy	12 Fertilizer storage	None known	
	3 Watertight sewer lines	8 Sewage lagoon	13 Insecticide storage		
	4 Lateral lines	9 Feedyard	14 Abandoned water well		
	5 Cess Pool	10 Livestock pens	15 Oil well/Gas well		
	Direction from well?		How many feet?		

FROM	TO	PLUGGING MATERIALS
51	20	Chlorinated Sand
20	4	Concrete Grout
4	0	Compacted Soil

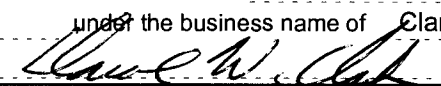7	CONTRACTOR'S OR LANDOWNER'S CERTIFICATION: This water well was plugged under my jurisdiction and was completed on (mo/day/year) 8-10-01 and this record is true to the best of my knowledge and belief. Kansas Water Well Contractor's License No. 185 This Water Well Record was completed on (mo/day/year) 8-23-01 under the business name of Clarke Well & Equipment, Inc.
	by (signature) 

INSTRUCTIONS: Use typewriter or ball point pen. Please press firmly and print clearly. Please fill in blanks, underline or circle the correct answers. Send top three copies to Kansas Department of Health & Environment, Bureau of Water, Topeka, Kansas 66620-0001. Telephone: 785/296-3565. Send one to Water Well Owner and retain one for your records.