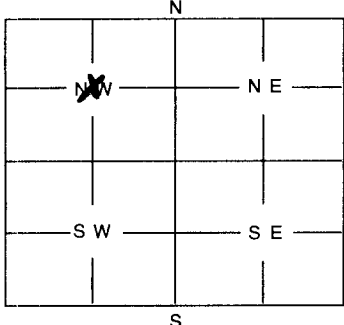


1	LOCATION OF WATER WELL:	Fraction	Section Number	Township Number	Range Number
	County: <u>Sedgwick</u>	$\frac{1}{4}$ <u>C</u> $\frac{1}{4}$ <u>NW</u>	<u>22</u>	<u>25</u>	<u>1 W</u>

Distance and direction from nearest town or city street address of well if located within city?

From Sedgwick KS: 3 1/2 miles South and 1/4 mile East

2	WATER WELL OWNER: <u>Robert M. Danicks</u>	Board of Agriculture, Division of Water Resources
	RR #, St. Address, Box #: <u>130 S Miles Avenue</u>	Application Number: <u>29048</u>
	City, State, ZIP Code: <u>Valley Center, KS 67447</u>	

3	MARK WELL'S LOCATION WITH AN "X" IN SECTION BOX:	4	DEPTH OF WELL <u>45.5</u> ft												
			WELL'S STATIC WATER LEVEL <u>16.5</u> ft.												
			WELL WAS USED AS:												
			<table border="0"> <tr> <td>1 Domestic</td> <td>5 Public Water Supply</td> <td>9 Dewatering</td> </tr> <tr> <td>2 Irrigation</td> <td>6 Oil Field Water Supply</td> <td>10 Monitoring Well</td> </tr> <tr> <td>3 Feedlot</td> <td>7 Domestic (Lawn & Garden)</td> <td>11 Injection Well</td> </tr> <tr> <td>4 Industrial</td> <td>8 Air Conditioning</td> <td>12 Other</td> </tr>
			Was a chemical / bacteriological sample submitted to Department? Yes <u>X</u> No												
			If yes, mo/day/yr sample was submitted												
			Water Well Disinfected: Yes <u>X</u> No												

5	TYPE OF BLANK CASING USED:
	☒ Steel 3 RMP (SR) 5 Wrought 7 Fiberglass 9 Other (Specify below) ☐ PVC 4 ABS 6 Asbestos-Cement 8 Concrete Tile
	Blank casing diameter <u>16</u> in. Was casing pulled? Yes No <u>X</u> If yes, how much
	Casing height above or below surface <u>36</u> in.

6	GROUT PLUG MATERIAL: 1 Neat cement ☒ Cement grout 3 Bentonite 4 Other Grout Plug Intervals: From <u>3</u> ft. to <u>16.5</u> ft., From ft. to ft., From ft. to ft.																				
	What is the nearest source of possible contamination:																				
	<table border="0"> <tr> <td>1 Septic tank</td> <td>6 Seepage pit</td> <td>11 Fuel storage</td> <td>16 Other (specify below)</td> </tr> <tr> <td>2 Sewer lines</td> <td>7 Pit privy</td> <td>12 Fertilizer storage</td> <td><u>None</u></td> </tr> <tr> <td>3 Watertight sewer lines</td> <td>8 Sewage lagoon</td> <td>13 Insecticide storage</td> <td><u>Open Field</u></td> </tr> <tr> <td>4 Lateral lines</td> <td>9 Feedyard</td> <td>14 Abandoned water well</td> <td></td> </tr> <tr> <td>5 Cess Pool</td> <td>10 Livestock pens</td> <td>15 Oil well/Gas well</td> <td></td> </tr>
	Direction from well? How many feet?																				

FROM	TO	PLUGGING MATERIALS
<u>0</u>	<u>3</u>	<u>Topsoil</u>
<u>3</u>	<u>16.5</u>	<u>Cement</u>
<u>16.5</u>	<u>45.5</u>	<u>Gravel</u>

outside of casing
0-3 topsoil
3-6 cement
6-7 Neat cement

7	CONTRACTOR'S OR LANDOWNER'S CERTIFICATION: This water well was plugged under my jurisdiction and was completed on (mo/day/year) <u>7-26-02</u> and this record is true to the best of my knowledge and belief. Kansas Water Well Contractor's License No. <u>238</u> This Water Well Record was completed on (mo/day/year) <u>7-31-02</u> under the business name of <u>Waninger Irrigation</u> by (signature) <u>[Signature]</u>
---	--

INSTRUCTIONS: Use typewriter or ball point pen. Please press firmly and print clearly. Please fill in blanks, underline or circle the correct answers. Send top three copies to Kansas Department of Health and Environment, Bureau of Water, Topeka, Kansas 66620-0001. Telephone: 785/296-3565. Send one to Water Well Owner and retain one for your records.