GSI Job No. 047343 **VEW**

WATER WELL RECORD Form WWC-5 KSA 82a-1212 ID No. **00360504**

1 LOCATION OF WATER WELL:	Fraction	Section Number	Township Number	Range Number
County: **Sedgwick**	**SE** ¼ **SE** ¼ **NE** ¼	**36**	T **25** S	R **1** W

Distance and direction from nearest town or city street address of well if located within city?
126 W. Main Street, Valley Center

2 WATER WELL OWNER: **Valley Drug**
RR#, St. Address, Box # : **126 W. Main Street**
City, State, ZIP Code : **Valley Center, KS 67147**

Board of Agriculture, Division of Water Resources
Application Number:

3 LOCATE WELL'S LOCATON WITH AN "X" IN SECTION BOX:

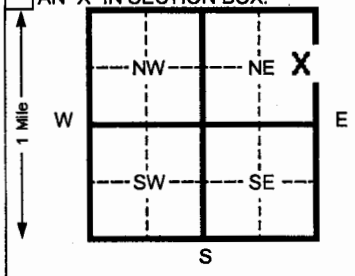

4 DEPTH OF COMPLETED WELL **18** ft. ELEVATION: **1344.46 (TOC)**

Depth(s) Groundwater Encountered 1 **12.5** ft. 2 ____ ft. 3 ____ ft.

WELL'S STATIC WATER LEVEL **13.11** ft. below land surface measured on mo/day/yr **2-28-05**

Pump test data: Well water was ____ ft. after ____ hours pumping ____ gpm

Est. Yield ____ gpm: Well water was ____ ft. after ____ hours pumping ____ gpm

Bore Hole Diameter **8** in. to **18** ft. and ____ in. to ____ ft.

WELL WATER TO BE USED AS: 1 Domestic 3 Feed lot 5 Public water supply 6 Oil field water supply 8 Air conditioning 9 Dewatering 11 Injection well 12 Other (Specify below) 2 Irrigation 4 Industrial 7 Lawn and garden (domestic) [10 Monitoring well]

Was a chemical/bacteriological sample submitted to Department? Yes ____ No **X** If yes, mo/day/yr sample was submitted ____ Water Well Disinfected? Yes ____ No **X**

5 TYPE OF BLANK CASING USED: 1 Steel 3 RMP (SR) 5 Wrought Iron 8 Concrete tile CASING JOINTS: Glued ____ Clamped ____ Welded [Threaded **Flush**] [2 PVC] 4 ABS 6 Asbestos-Cement 9 Other (specify below) 7 Fiberglass

Blank casing diameter **4** in. to **8** ft., Dia ____ in. to ____ ft., Dia ____ in. to ____ ft.

Casing height above land surface **Flushmount** in., weight **2.0** lbs./ft. Wall thickness or gauge No. **Sch. 40**

TYPE OF SCREEN OR PERFORATION MATERIAL: [7 PVC] 10 Asbestos-cement
1 Steel 3 Stainless steel 5 Fiberglass 8 RMP (SR) 11 Other (specify) ____
2 Brass 4 Galvanized steel 6 Concrete tile 9 ABS 12 None used (open hole)

SCREEN OR PERFORATION OPENINGS ARE: 5 Gauzed wrapped 8 Saw cut 11 None (open hole)
1 Continuous slot [3 Mill slot] 6 Wire wrapped 9 Drilled holes
2 Louvered shutter 4 Key punched 7 Torch cut 10 Other (specify) ____

SCREEN-PERFORATED INTERVALS: From **8** ft. to **18** ft. From ____ ft. to ____ ft.
From ____ ft. to ____ ft. From ____ ft. to ____ ft.

GRAVEL PACK INTERVALS: From **6** ft. to **18** ft. From ____ ft. to ____ ft.
From ____ ft. to ____ ft. From ____ ft. to ____ ft.

6 GROUT MATERIAL: 1 Neat cement 2 Cement grout [3 Bentonite] 4 Other

Grout Intervals From **1** ft. to **6** ft. From ____ ft. to ____ ft. From ____ ft. to ____ ft.

What is the nearest source of possible contamination:
1 Septic tank 4 Lateral lines 7 Pit privy 10 Livestock pens 14 Abandoned water well
2 Sewer lines 5 Cess pool 8 Sewage lagoon 11 Fuel storage 15 Oil well/ Gas well
3 Watertight sewer lines 6 Seepage pit 9 Feedyard 12 Fertilizer storage 16 Other (specify below)
13 Insecticide storage

Direction from well? How many feet?

FROM	TO	CODE	LITHOLOGIC LOG	FROM	TO	PLUGGING INTERVALS
0	1		Asphalt, concrete, base			
1	6		Silty Clay			
6	11		Sand and gravel			
11	12		Silty Clay			
12	18		Sand and gravel			

7 CONTRACTOR'S OR LANDOWNER'S CERTIFICATION: This water well was [(1) constructed], (2) reconstructed, or (3) plugged under my jurisdiction and was completed on (mo/day/yr) **3-9-05** and this record is true to the best of my knowledge and belief. Kansas Water Well Contractor's License No. **531** This Water Well Record was completed on (mo/day/yr) **4-26-05** under the business name of **Geotechnical Services, Inc.** by (signature)

INSTRUCTIONS:. Please fill in blanks and circle the correct answers. Send three copies to Kansas Department of Health and Environment, Bureau of Water, 1000 S W Jackson St., Ste. 420, Topeka, Kansas 66612-1367. Telephone: 913-296-5545. Send one to WATER WELL OWNER and retain one for your records.

OFFICE USE ONLY T R SEC

Form provided by Forms-On-A-Disk, Inc. · Dallas, Texas · (214) 340-9429