

Phone 24

ANDERSEN & DARLING
JAMESTOWN, KANSAS

Sedgwick

Phone 705



—Log Of Test Well—

Date of Test 2-14-56

Customer Glenn Dick Address R.F.D. Sedgwick

Location 5 1/2 of NE 1/4 17-25-1 West. Sedgwick Co.

Static Water Level 22'

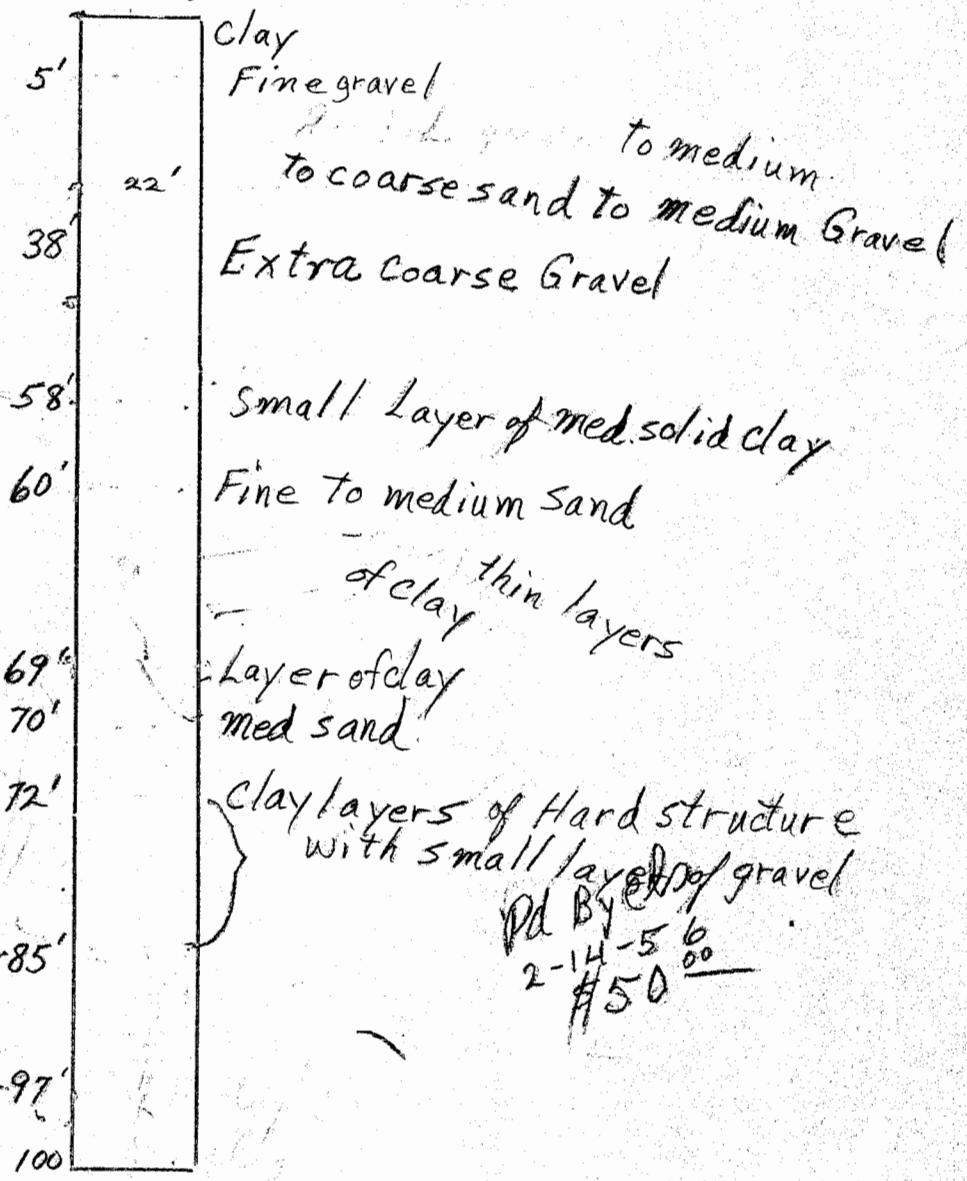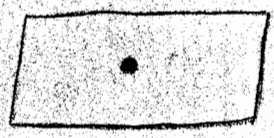

Paid in Full \$100.00
100 ft dep 71.50

med sand to med gravel
Loose Formation

Pd By
2-14-56
#50

Andersen & Darling Drilling
By Harry A. Anderson

Glenn Dick. Sedgwick.
- Well Pumping Test -

Water level	-	15' 4"
385 g.p.m.		18' 8"
475 "		19' 6"
600 "		21'

Glen Dick R.F.D. Sedgwick Kans.

Location $S\frac{1}{2}$ of $NE\frac{1}{4}$ 17-25-1 West Sedgwick Co.

- Construction of Irrigation Well - 4/24/56

Well Finished 73 ft depth - 36" Bore

No. ft. of Plain Casing 33' gauge 10 dipped Diameter 18"

No. ft. Perf " 40' gauge 10 dipped Diameter 18"

Gravel pack 15 yds