


201 S. Cedar, Valley Center

RR#, St. Address, Box # : 201 S. Cedar
City, State, ZIP Code : Valley Center 67147

Board of Agriculture, Division of Water Resources
Application Number:

4	DEPTH OF COMPLETED WELL	25	ft. ELEVATION:
---	-------------------------	----	----------------

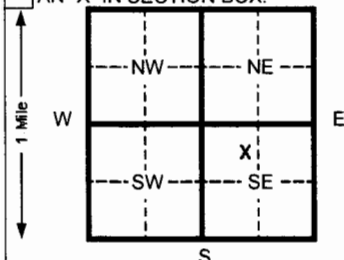

2 Irrigation 4 Industrial 7 Lawn and garden (domestic) **10 Monitoring well** _____

Was a chemical/bacteriological sample submitted to Department? Yes _____ No **X** If yes, mo/day/yr sample was submitted _____
Water Well Disinfected? Yes _____ No **X**

Jackson St., Ste. 420, Topeka, Kansas 66612-1367. Telephone: 913-296-5545. Send one to WATER WELL OWNER and retain one for your records.