

WATER WELL PLUGGING RECORD Form WWC-5P KSA 82a-1212 ID NO.

NA

1 LOCATION OF WATER WELL: Fraction Section Number Township Number Range Number
 County: **Sedgwick** SW ¼ NW ¼ SE ¼ **36** **25S** **1** W

Distance and direction from nearest town or city street address of well if located within city?
1000 ft Southwest of Valley Center

2 WATER WELL OWNER: **Barton Solvents**

RR#, St. Address, Box #: **201 S. Cedar**

City, State, ZIP Code: **Valley Center, KS 67147**

Global Positioning System (decimal degrees, min. of 4 digits)

Latitude: _____


Longitude: _____

Elevation: _____

Datum: _____

Data Collection Method: _____

3 MARK WELL'S LOCATION WITH AN "X" IN SECTION BOX:

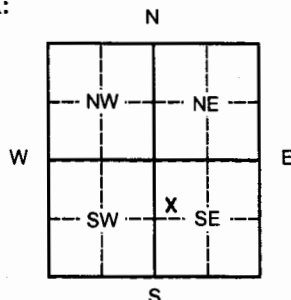

4 DEPTH OF WELL **30.8** ft.

WELL'S STATIC WATER LEVEL **16.8** ft

WELL WAS USED AS:

1 Domestic

2 Irrigation

3 Feedlot

4 Industrial

5 Public Water Supply

6 Oil Field Water Supply

7 Domestic (Lawn & Garden)

8 Air Conditioning

9 Dewatering

10 Monitoring

11 Injection Well

12 Other **Air Sparge**

Was a chemical/bacteriological sample submitted to Department? Yes ___ No **X**

5 TYPE OF BLANK CASING USED:

1 Steel

3 RMP (SR)

5 Wrought

7 Fiberglass

9 Other (Specify below)

2 **PVC**

4 ABS

6 Asbestos-Cement

8 Concrete Tile

Blank casing diameter **2** in. Was casing pulled? Yes ___ No **X** If yes, how much _____
 Casing height above or below land surface **36** in.

6 GROUT PLUG MATERIAL: 1 Neat cement 2 Cement grout 3 **Bentonite** 4 Other **Soil**

Grout Plug Intervals: From **0.5** ft. to **30.8** ft., From _____ ft. to _____ ft., From _____ to _____ ft.

What is the nearest source of possible contamination:

1 Septic tank

6 Seepage pit

11 Fuel Storage

16 Other (specify below)

2 Sewer lines

7 Pit privy

12 Fertilizer storage

3 Watertight sewer lines

8 Sewage lagoon

13 Insecticide storage

4 Lateral lines

9 Feedyard

14 Abandoned water well

Direction from well?

5 Cess pool

10 Livestock pens

15 Oil well/Gas well

How many feet?

FROM	TO	PLUGGING MATERIALS	FROM	TO	PLUGGING MATERIALS
0	0.5	Native Soil			
0.5	30.8	Bentonite Chips			

7 CONTRACTOR'S OR LANDOWNER'S CERTIFICATION: This water well was plugged under my jurisdiction and was completed on (mo/day/year) **10/01/08** and this record is true to the best of my knowledge and belief. Kansas Water Well Contractor's License No. **531**. This Water Well Record was completed on (mo/day/year) **11/07/08** under the business name of **Geotechnical Services, Inc.** by (signature) *[Signature]*

INSTRUCTIONS: Please fill in blanks or circle the correct answers. Send top three copies to Kansas Department of Health and Environment, Bureau of Water, Geology Section, 1000 SW Jackson St., Ste. 420, Topeka, Kansas 66612-1367. Telephone: 785/296-5522. Send one to Water Well Owner and retain one for your records. Visit us at <http://www.kdheks.gov/waterwell>.