


201 S. Cedar – Valley Center

RR#, St. Address, Box # : **201 S. Cedar**
City, State, ZIP Code : **Valley Center, KS 67147**

Board of Agriculture, Division of Water Resources
Application Number:

3	LOCATE WELL'S LOCATON WITH AN "X" IN SECTION BOX:
---	---

4	DEPTH OF COMPLETED WELL	33	ft. ELEVATION:
---	-------------------------	----	----------------

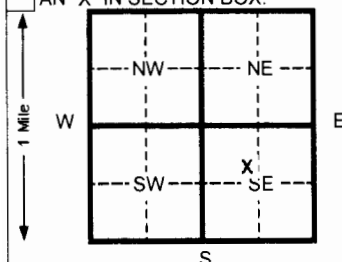

DEPTH OF COMPLETED WELL _____ ft. 1 _____ ft. 2 _____ ft. 3 _____ ft.

WELL'S STATIC WATER LEVEL **NA** ft. below land surface measured on mo/day/yr _____

Pump test data: Well water was _____ ft. after _____ hours pumping _____ gpm

Est. Yield _____ gpm: Well water was _____ ft. after _____ hours pumping _____ gpm

Bore Hole Diameter **8.25** in. to **33** ft. and _____ in. to _____ ft.

WELL WATER TO BE USED AS:

5 Public water supply	8 Air conditioning	11 Injection well		
1 Domestic	3 Feed lot	6 Oil field water supply	9 Dewatering	12 Other (Specify below)
2 Irrigation	4 Industrial	7 Lawn and garden (domestic)	10 Monitoring well	Air Sparge

Was a chemical/bacteriological sample submitted to Department? Yes _____ No **X** If yes, mo/day/yr sample was submitted _____

Water Well Disinfected? Yes _____ No **X**

5 TYPE OF BLANK CASING USED.		5 Wrought Iron	8 Concrete tile	CASING JOINTS: Glued _____ Clamped _____	
1 Steel	3 RMP (SR)	6 Asbestos-Cement	9 Other (specify below)	Welded	
2 PVC	4 ABS	7 Fiberglass		Threaded	Flush

Blank casing diameter	2	in. to	30	ft. Dia	in. to	ft. Dia	in. to	ft.
Casing height above land surface	Flush	in., weight	0.703	lbs./ft. Wall thickness or gauge No	SCH. 40			

TYPE OF SCREEN OR PERFORATION MATERIAL:

1 Steel	3 Stainless steel	5 Fiberglass	8 RMP (SR)	11 Other (specify) _____
2 Brass	4 Galvanized steel	6 Concrete tile	9 ABS	12 None used (open hole)

SCREEN OR PERFORATION OPENINGS ARE:

1 Continuous slot	3 Mill slot	6 Wire wrapped	9 Drilled holes
2 Louvered shutter	4 Key punched	7 Torch cut	10 Other (specify)

SCREEN-PERFORATED INTERVALS:	From	30	ft. to	33	ft. From		ft. to		ft.
	From		ft. to		ft. From		ft. to		ft.
GRAVEL PACK INTERVALS:	From	28	ft. to	33	ft. From		ft. to		ft.
	From		ft. to		ft. From		ft. to		ft.

6	GROUT MATERIAL:		1 Neat cement	2 Cement grout	3 Bentonite	4 Other						
Grout Intervals		From	1	ft. to	26	ft. From	26	ft. to	28	ft. From	ft. to	ft.

What is the nearest source of possible contamination:			10 Livestock pens	14 Abandoned water well
1 Septic tank	4 Lateral lines	7 Pit privy	11 Fuel storage	15 Oil well/ Gas well
2 Sewer lines	5 Cess pool	8 Sewage lagoon	12 Fertilizer storage	16 Other (specify below)
3 Watertight sewer lines	6 Seepage pit	9 Feedyard	13 Insecticide storage	

Direction from well? _____ How many feet? _____

[illegible]

7 CONTRACTOR'S OR LANDOWNER'S CERTIFICATION: This water well was (1) constructed, (2) reconstructed, or (3) plugged under my jurisdiction and was completed on (mo/day/yr) 02/12/09 and this record is true to the best of my knowledge and belief. Kansas
Water Well Contractor's License No. 531 This Water Well Record was completed on (mo/day/yr) 03/03/09
under the business name of Geotechnical Services Inc. by (signature) [Signature]

INSTRUCTIONS: Please fill in blanks and circle the correct answers. Send three copies to Kansas Department of Health and Environment, Bureau of Water, 1000 S W Jackson St., Ste. 420, Topeka, Kansas 66612-1367. Telephone: 913-296-5545. Send one to WATER WELL OWNER and retain one for your records.