


WATER WELL RECORD Form WWC-5 KSA 82a-1212

1 LOCATION OF WATER WELL: Sedgwick	FRACTION NE 1/4 NE 1/4 NW 1/4	SECTION NUMBER 36	TOWNSHIP NUMBER T 25 S	RANGE NUMBER R 1W E/W
--	---	-----------------------------	----------------------------------	---------------------------------

Distance and direction from nearest town or city street address of well if located within city?

526 Back Woods Valley Center, Kansas

2 WATER WELL OWNER: SANDERS LIFESTYLES	Board of Agriculture, Division of Water Resource
RR#,ST. ADDRESS,BOX #: P.O. Box 9124	Application Number:
CITY, STATE: Wichita, Kansas	ZIP CODE:

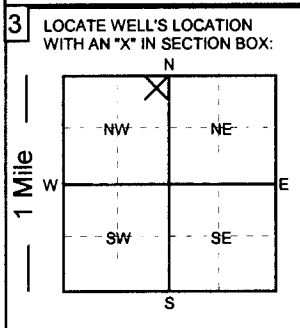

4 DEPTH OF COMPLETED WELL: 46 ft.	ELEVATION:
Depth of groundwater Encountered: _____ ft.	_____ ft.
WELL'S STATIC WATER LEVEL 12 FT. BELOW LAND SURFACE MEASURED ON 11/2/16	
Pump test data: Well water was _____ ft. after _____ hours of pumping @ _____ gpm	
Est. Yield: _____ gpm Well water was _____ ft. after _____ hours of pumping @ _____ gpm	
Bore Hole Diameter 12 in. to 46 ft. and _____ in. to _____ ft.	
WELL WATER TO BE USED AS:	
1. Domestic 3. Feedlot 5. Public water supply 7. Lawn and garden only 9. Dewatering 11. Injection well	12. Other (Specify below)
2. Irrigation 4. Industrial 6. Oil field water supply 8. Air conditioning 10. Monitoring well	
Was a chemical/bacteriological sample submitted to Department? YES NO ; If yes, what mo/day/yr was sample submitted	
Was Water Well Disinfected? YES NO	

5 TYPE OF CASING USED:		5. Wrought iron	7. Fiberglass	9. Other (Specify below)	CASING JOINTS:	Glued	Threaded
1. Steel	3. RPM (SR)	6. Asbestos-Cement	8. Concrete tile	SDR-26	Welded	Clamped	
2. PVC	4. ABS						
Blank casing diameter 5 in. to 35 ft., Dia. _____ in. to _____ ft., Dia. _____ in. to _____ ft.							
Casing height above land surface: 12 in., Weight: 2.35 lbs. / ft. Wall thickness or gauge No. .214							
TYPE OF SCREEN OR PERFORATION MATERIAL:							
1. Steel	3. Stainless Steel	5. Fiberglass	7. PVC	9. ABS	11. Other (specify)		
2. Brass	4. Galvanized	6. Concrete Tile	8. RMP (SR)	10. Asbestos-Cement	12. None used (open hole)		
SCREEN OR PERFORATION OPENINGS ARE:							
1. Continuous slot	3. Mill slot	5. Gauzed wrapped	7. Torch cut	9. Drilled holes	11. None (open hole)		
2. Louvered shutter	4. Key punched	6. Wire wrapped	8. Saw cut	10. Other (specify)			
SCREEN - PERFORATION INTERVAL	From 35 ft. to 46 ft.,	From _____ ft. to _____ ft.,	From _____ ft. to _____ ft.,	From _____ ft. to _____ ft.,			
GRAVEL PACK INTERVALS:	From 24 ft. to 46 ft.,	From _____ ft. to _____ ft.,	From _____ ft. to _____ ft.,	From _____ ft. to _____ ft.,			

6 GROUT MATERIALS:		1. Neat cement	2. Cement Grout	3. Bentonite	Other bentonite hole plug
Grout Intervals:	From 4 ft. to 24 ft.,	From _____ ft. to _____ ft.,	From _____ ft. to _____ ft.,	From _____ ft. to _____ ft.,	
What is the nearest source of possible contamination:					
1. Septic tank	4. Lateral lines	7. Pit privy	10. Livestock pens	13. Insecticide storage	15. Oil well/Gas well
2. Sewer lines	5. Cess Pool	8. Sewage lagoon	11. Fuel storage	14. Abandon water well	16. Other (specify below)
3. Watertight sewer line	6. Seepage pit	9. Feed yard	12. Fertilizer storage		
Direction from well? South					How many feet? 50 ft. plus

From	To	LITHOLOGIC LOG	From	To	LITHOLOGIC LOG
0	3	topsoil			
3	8	clay			
8	35	fine sand			
35	46	medium sand			

7 Contractor's or Landowner's Certification: This water well was 1. constructed 2. reconstructed or 3. plugged under my jurisdiction and was completed on (mo/day/year) 11/02/2016 and this record is true to the best of my knowledge and belief.	
Kansas Water Well Contractor's License No. 236	This water well record was completed on (mo/day/year) 11/07/2016
under the business name of Harp Well and Pump Service	by (signature) Todd S. Harp