48360 - south well

WATER WELL PLUGGING RECORD Form WWC-5P KSA 82a-1212 ID NO.

1 LOCATION OF WATER WELL: County: Sedgwick | Fraction: ¼ NW ¼ SW ¼ SW ¼ | Section Number: 02 | Township Number: T 25 S | Range Number: 1 ☐ E ☑ W

Street/Rural Address of Well Location; if unknown, distance & direction from nearest town or intersection: If at owner's address, check here ☐ Located approximately 0.5 miles east and 0.75 miles south of Sedgwick, KS

Global Positioning Systems (GPS) information:
Latitude: 37.89976 (in decimal degrees)
Longitude: -97.40835 (in decimal degrees)
Elevation:
Horizontal Datum: ☐ WGS84, ☐ NAD83, ☑ NAD27
Collection Method:
☑ GPS unit (Make/Model: Garmin GPSmap 60CSx
☐ Digital Map/Photo, ☐ Topographic Map, ☐ Land Survey
Est. Accuracy: ☐ < 3 m, ☑ 3-5 m, ☐ 5-15 m, ☐ > 15 m

2 WATER WELL OWNER: Barbara Anne Works Liv Trust
RR#, St. Address, Box #: 12158 N Hoover Rd
City, State ZIP Code: Sedgwick, KS 67135

3 MARK WELL'S LOCATION WITH AN "X" IN SECTION BOX:

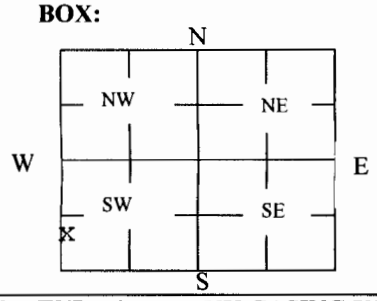

4 DEPTH OF WELL 57.3 ft.
WELL'S STATIC WATER LEVEL 16.92 ft
WELL WAS USED AS:

☐ Domestic	☐ Public Water Supply	☐ Dewatering	
☑ Irrigation	☐ Oil Field Water Supply	☐ Monitoring	
☐ Feedlot	☐ Domestic (Lawn & Garden)	☐ Injection Well	
☐ Industrial	☐ Air Conditioning	☐ Other	

Was a chemical/bacteriological sample submitted to Department? Yes ☐ No ☑

5 TYPE OF BLANK CASING USED:

☐ Steel	☐ RMP (SR)	☐ Wrought	☐ Fiberglass	☐ Other (Specify below)
☑ PVC	☐ ABS	☐ Asbestos-Cement	☐ Concrete Tile	

Blank casing diameter 8 in. Was casing pulled? Yes ☐ No ☑ If yes, how much
Casing height above or below land surface below 36 in.

6 GROUT PLUG MATERIAL: ☐ Neat cement ☐ Cement grout ☑ Bentonite ☐ Other

Grout Plug Intervals: From 16.92 ft. to 3 ft., From ft. to ft., From ft. to ft.

What is the nearest source of possible contamination:

☐ Septic tank	☐ Seepage pit	☑ Fuel storage	☑ Other (specify below)
☐ Sewer lines	☐ Pit privy	☐ Fertilizer storage	
☐ Watertight sewer lines	☐ Sewage lagoon	☐ Insecticide storage	
☐ Lateral lines	☐ Feedyard	☐ Abandoned water well	Direction from well? southwest
☐ Cess pool	☐ Livestock pens	☐ Oil well/Gas well	How many feet? approximately 1095 feet

FROM	TO	PLUGGING MATERIALS	FROM	TO	PLUGGING MATERIALS
57.3	16.92	Clean, course sand			Well plugging witnessed by
16.92	3	Bentonite Hole Plug			D. Randolph, GMD2 staff,
3	0	Topsoil			on 12/12/2016.

7 CONTRACTOR'S OR LANDOWNER'S CERTIFICATION: This water well was plugged under my jurisdiction and was completed on (mo/day/year) 12/12/2016 and this record is true to the best of my knowledge and belief. Kansas Water Well Contractor's License No. . This Water Well Record was completed on (mo/day/year) 12/20/2016 under the business name of by (signature) Barb Works Trustee

RECEIVED
JAN 05 2017
Equus Beds Groundwater Management District No. 2

Send one copy to Kansas Department of Health & Environment, Geology Section, 1000 SW Jackson Street, Ste. 420, Topeka, KS 66612-1367. Send one copy to WATER WELL OWNER and retain one for your records.
Visit us at http://www.kdheks.gov/waterwell/index.html Telephone 785-296-5524.

KSA82a-1212 **Revised 1/20/2015**