


1 LOCATION OF WATER WELL:	Fraction <i>Near Center</i>	Section Number	Township Number	Range Number
County: <i>Sedawick</i>	<i>NE 1/4</i>	<i>6</i>	T <i>25</i> S	R <i>1</i> <i>SW</i>

Distance and direction from nearest town or city street address of well if located within city? Iron Ridge &
2 1/4 mi. west and 1/4 mi. south of Sedgewick, Kansas, Hagstoad Rd.

2	WATER WELL OWNER: Charles M. Loyd	
	RR#, St. Address, Box # : P.O. Box 308	Board of Agriculture, Division of Water Resources
	City, State, ZIP Code : Sedgewick, KS 67135	Application Number: 28628

3 LOCATE WELL'S LOCATION WITH AN "X" IN SECTION BOX: 4 DEPTH OF COMPLETED WELL. 73 ft. ELEVATION:

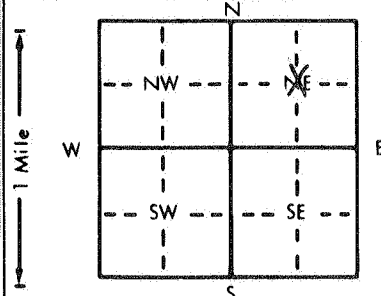

4 DEPTH OF COMPLETED WELL. 73 ft. ELEVATION: _____
 Depth(s) Groundwater Encountered 1. _____ ft. 2. _____ ft. 3. _____ ft.

Depth(s) Groundwater Encountered 1. ft. 2. ft. 3. ft.
WELL'S STATIC WATER LEVEL 24 ft. below land surface measured on mo/day/yr 7/11/93

WELL'S STATIC WATER LEVEL ... 29 ... ft. below land surface measured on mo/day/yr ... 1/1/93 ...

Pump test data: Well water was ft. after hours pumping gpm

Est. Yield gpm: Well water was ft. after hours pumping gpm

Bore Hole Diameter: WAS in. to . ft., and . in. to . ft.

WELL WATER TO BE USED AS: 5 Public water supply 8 Air conditioning 11 Injection well

1 Domestic	3 Feedlot	6 Oil field water supply	9 Dewatering	12 Other (Specify below)
------------	-----------	--------------------------	--------------	--------------------------

2 Irrigation 4 Industrial 7 Lawn and garden only 10 Monitoring well

Was a chemical/bacteriological sample submitted to Department? Yes.....No X.....; If yes, mo/day/yr sample was sub

5	TYPE OF BLANK CASING USED:	5 Wrought iron	8 Concrete tile	CASING JOINTS: Glued Clamped
---	----------------------------	----------------	-----------------	--

1 Steel 3 RMP (SR) 6 Asbestos-Cement 9 Other (specify below) Welded

Blank	2 PVC	4 ABS	7 Fiberglass			Threaded.....
Blank casing diameter	16	in. to	ft. Dia	in. to	ft. Dia	in. to

Casing height above land surface..... 12 in. weight..... lbs./ft. Wall thickness or gauge No.

TYPE OF SCREEN OR PERFORATION MATERIAL:	7 PVC	10 Asbestos-cement
---	-------	--------------------

1 Steel	3 Stainless steel	5 Fiberglass	8 RMP (SR)	11 Other (specify)
2 Brass	4 Galvanized steel	6 Concrete/tile	9 ABS	10 None used (open hole)

SCREEN OR PERFORATION OPENINGS ARE:

1 Continuous slot	3 Mill slot	6 Wire wrapped	9 Drilled holes
-------------------	-------------	----------------	-----------------

2 Louvered shutter 4 Key punched 7 Torch cut 10 Other (specify)

SCREEN PERFORATED INTERVALS: From ft. to ft. From ft. to ft.

SCREEN-PERFORATED INTERVALS: From ft. to ft. From ft. to ft.
From ft. to ft. From ft. to ft.

GRAVEL PACK INTERVALS: From ft. to ft., From ft. to ft.

		From		ft. to		ft., From		ft. to		ft.	
C	CRUIT MATERIAL:	1. Neat cement	2. Cement grout	3. Bentonite	4. Other						

6. GROUT MATERIAL: 1 Neat cement 2 Cement grout 3 Bentonite 4 Other

Grout Intervals: From ft. to ft. From ft. to ft. From ft. to ft.

What is the nearest source of possible contamination: 10 Livestock pens 14 Abandoned water well

1 Septic tank	4 Lateral lines	7 Pit privy	11 Fuel storage	15 Oil well/Gas well
2 Sewer lines	5 Cess pond	8 Sewerage treatment	12 Fuel storage	16 Other (specify) _____

2 Sewer lines	5 Cess pool	8 Sewage lagoon	12 Fertilizer storage	16 Other (specify below)
3 Watertight sewer lines	6 Seepage pit	9 Feedyard	13 Insecticide storage	Tailwater pit

Direction from well? West How many feet? 7

FROM	TO	LITHOLOGIC LOG	FROM	TO	PLUGGING INTERVALS
			72	311.5	Sand

			13	24.5	Sand
			24.5	22.5	Bentonite

			22.5	4	Cement Grout
--	--	--	------	---	--------------

			4	3	Bentonite
			3	0	concrete

			3	✓	CEMENT + Grout

* Plugged to top of casing and concrete slab

Discharge L. 8/25/93 VINE WAIVER

18 0/29/13 RPHL Waiver.

[illegible]

1	2	
---	---	---	---	---	---	---	---	---	----	----	-----	-----	

[illegible]

7 CONTRACTOR'S OR LANDOWNER'S CERTIFICATION: This water well was (1) constructed, (2) reconstructed, or (3) plugged under my jurisdiction and was

completed on (mo/day/year) 8-31-93 and this record is true to the best of my knowledge and belief. Kansas
Water Well Contractor's License No. N/A This Water Well Record was completed on (mo/day/yr) 8-31-93

under the business name of N/A by (signature) Charles M. Land

INSTRUCTIONS: Use typewriter or ball point pen. PLEASE PRESS FIRMLY and PRINT clearly. Please fill in blanks, underline or circle the correct answers. Send top three copies to Kansas Department of Health and Environment, Bureau of Water, Topeka, Kansas 66620-0001. Telephone: 913-236-5545. Send one to WATER WELL OWNER and retain one for your records.

of Health and Environment, Bureau of Water, Topeka, Kansas 66620-0001. Telephone: 913-236-5340. Send one to WATER WELL OWNER and retain one for your records.