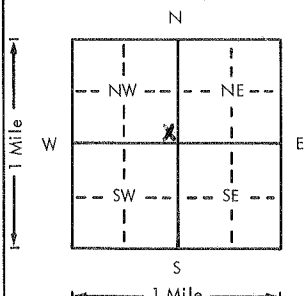


USE TYPEWRITER OR BALL
POINT PEN-PRESS FIRMLY,
PRINT CLEARLY.

WATER WELL RECORD
KSA 82a-1201-1215

Kansas Department of Health and
Environment-Division of Environment
(Water well Contractors)
Topeka, Kansas 66620

1. Location of well:		County SEDGWICK	Fraction SE 1/4 SE 1/4 NW 1/4	Section number 6	Township number T 25 S	Range number R 1 W	E/W
2. Distance and direction from nearest town or city: 2 MILES West				3. Owner of well: T.C. CARTER			
Street address of well location if in city: 150. SEDGWICK				R.R. or street: R.R. SEDGWICK, KS. 67135			
4. Locate with "X" in section below:				Sketch map:		6. Bore hole dia. 30 in. Completion date 5-19 Well depth 85 ft. 77	
						7. ☐ Cable tool ☐ Rotary ☐ Driven ☐ Dug ☐ Hollow rod ☐ Jetted ☐ Bored ☒ Reverse rotary	
5. Type and color of material				From	To	8. Use: ☐ Domestic ☐ Public supply ☐ Industry ☒ Irrigation ☐ Air conditioning ☐ Stock ☐ Lawn ☐ Oil field water ☐ Other	
Top SOIL - SANDY				0	3	9. Casing: Material PAV Height: Above or below Threaded ☐ Welded ☐ Surface 12 in. RMP ☐ PVC ☐ Weight 32 lbs./ft. Dia 1 1/2 in. to 55 ft. depth Wall Thickness: inches or Dia. ☐ in. to ☐ ft. depth gage No. 344	
CLAY - YELLOW				3	12	10. Screen: Manufacturer's name AUREA FINE CO Type PAVITE Dia. 1 1/2 in. Slot/gauze 48 Length 39 ft. Set between 4 1/2 ft. and 85 ft. ☐ ft. and ☐ ft.	
SAND - FINE				12	19	Gravel pack? yes Size range of material 4/4"	
SAND - COARSE				19	40	11. Static water level: ☐ mo./day/yr. 22 ft. below land surface Date 5-22-77	
SAND MED				40	70	12. Pumping level below land surfaces: ☐ ft. after ☐ hrs. pumping ☐ g.p.m. ☐ ft. after ☐ hrs. pumping ☐ g.p.m. Estimated maximum yield 1200 g.p.m.	
CLAY GREEN				70	72	13. Water sample submitted: ☐ mo./day/yr. ☐ Yes ☒ No Date ☐	
SAND - MED				72	82	14. Well head completion: ☐ Pitless adapter ☐ Inches above grade	
CLAY GOBY				82	85	15. Well grouted? yes Puddled clay With: ☐ Neat cement ☐ Bentonite ☐ Concrete Depth: From 0 ft. to 15 ft.	
						16. Nearest source of possible contamination: ft 1500 Direction N Type Well Well disinfected upon completion? ☐ Yes ☒ No	
						17. Pump: ☐ Not installed Manufacturer's name WESTERN HARD PUMP Model number 800 HP 1/2 Volts 240 Length of drop pipe 60 ft. capacity 1200 g.p.m. Type: ☐ Submersible ☒ Turbine ☐ Jet ☐ Reciprocating ☐ Centrifugal ☐ Other	
(Use a second sheet if needed)							
18. Elevation:		19. Remarks:			20. Water well contractor's certification: This well was drilled under my jurisdiction and this report is true to the best of my knowledge and belief. PETERSON TR. INC. 138A Business name License No. Address Box 150 Lindsborg, KS. Signed Wally Peterson Date 5-23-77 Authorized representative		
Topography: ☐ Hill ☐ Slope ☐ Upland ☒ Valley							

Forward the white, blue and pink copies to the Department of Health and Environment

Form WWC-5